

MISSISSIPPI DEPARTMENT OF NATURAL RESOURCES

Bureau of Land and Water Resources

Southport Mall

P.O. Box 10631

Jackson, Mississippi 39209

WATER WELL DRILLERS LOG

CODED

WASHINGTON
R46

July 05 1985 Lamp well & pump Washington
date well completed firm name county well located

LANDOWNER: Sid Law

description of formations encountered

from to

clay	0	23
Fine sand	23	56
coarse sand (shore)	56	116

Chatham, Mo.
(mailing address)

WELL LOCATION:

sec. 15 T. 14 N R. E
S 9 W
4 miles NW of Glennallen
(distance) (direction) (nearest town)

WELL PURPOSE:
(home, irrigation, municipal, industrial)

WELL COMPLETION DATA:

- (1) diameter (inches) 12"
- (2) total depth (feet) 116'
- (3) static water level (feet) 23' below top of ground.
- (4) casing Steel, 76'
(material) (depth)

(size) If telescope see back.

- (5) screen 40' 76'
(length) (depth to top)

12" Steel
(size) (material)

- (6) pump 40 2000
(HP) (yield gpm)

D91
(type power)


- (7) electric log NO
(yes or no)

(organization running log)

- (8) how well bottom plugged Steel Plate

DRILLERS REMARKS:

CODED

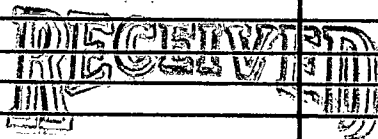


JUN 23 1986

Department of Natural Resources
Bureau of Land & Water

If well telescopes please
sketch and show depths.

GROUND LEVEL

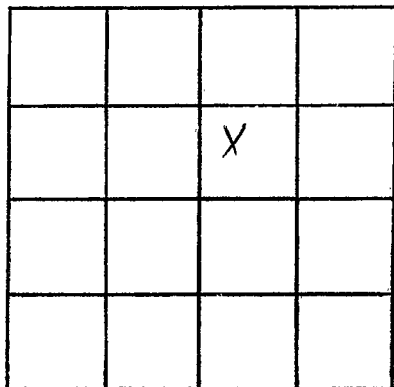

SECTION 15

Please indicate well location X.

ADDITIONAL INFORMATION

If more than one screen,
show locations of each on sketch.