

COUNTY WELL LOCATED  
Washington  
 WELL NUMBER A-58 CODED  
 DATE WELL COMPLETED  
5-30-01

33-05-23 91-06-37  
 PERMIT NUMBER  
 NAME OF DRILLING FIRM  
Schulster Ltd

NAME & MAILING ADDRESS OF LANDOWNER  
ERIC SCHULSTER  
Hwy 1 NORTH  
Greenville Ms 38701  
 WELL LOCATION: SEC 17 TOWNSHIP 14 RANGE 9  
 DISTANCE 7 Miles NW of Glenn Allen  
 OTHER LANDMARK  
 WELL PURPOSE: Home, Irrigation, Municipal, Industrial, Fish Pond, etc.

PUMP DATA  
 PUMP TYPE (Circle One):  
 Submersible, Turbine, Jet, Flowing Well,  
 Other (Describe)  
 POWER TYPE (Circle One):  
 Electric, Tractor, Diesel, Gasoline, Butane,  
 Other (Describe) H/P  
 Pump Capacity (GPM) No. of Stages Setting Depth FT.  
 PUMP TEST  
 Well yielded \_\_\_\_\_ GPM with  
 a drawdown of \_\_\_\_\_ ft.  
 after \_\_\_\_\_ hours of pumping

WELL DATA  
 Well Depth 110 Casing Diameter (In.) 16 Casing Length (Ft.) 90  
 Type of Casing pvc Hole Depth 112 Depth to Static Water Level  
 TYPE OF COMPLETION: (Circle One or More):  
Gravel Packed Underreamed, Telescoped,  
 Natural Development, Open Hole, Other  
 (Describe)  
 WELL GROUTED TO A DEPTH OF \_\_\_\_\_ FEET  
 Type Grout (circle one): Cement, Bentonite, or Mix

LOG DATA  
 TYPE OF LOG RUN (Circle One): No Log Run,  
 Electric, Gamma Ray, Density, Sonic, Neutron,  
 Other (Describe)  
 Name of Organization Running Log

SCREEN DATA  
 Diameter - inches 16 Length - Feet 20 Slot Size - Inches .032  
 Screen Type pvc Depth to Bottom - Feet 110

GEOLOGIC DATA (Office Use Only)  

Surface Elev.	Geologic Unit	Unit Thickness	Depth to Top
Subs. SWL	Date	Analysis	Aquifer Test

 Driller's Remarks  
 Top of Lap Pipe or Reduction in Casing  
 FEET IF TELESCOPED OR MORE THAN ONE SCREEN: USE BACK PAGE

DESCRIPTION OF FORMATIONS ENCOUNTERED	FROM	TO
<u>Top soil</u>	<u>0</u>	<u>10</u>
<u>clay</u>	<u>10</u>	<u>15</u>
<u>fine sand</u>	<u>15</u>	<u>88</u>
<u>med to coarse sand</u>	<u>88</u>	<u>90</u>
<u>coarse sand - p-gravel</u>	<u>90</u>	<u>110</u>
<u>and gravel</u>	<u>110</u>	<u>-112</u>


FORMATIONS (Continued)	FROM	TO

REC'D SEP 07 2001

IF MORE SPACE IS NEEDED, USE BACK

If well telescopes please sketch and show depths.

GROUND LEVEL

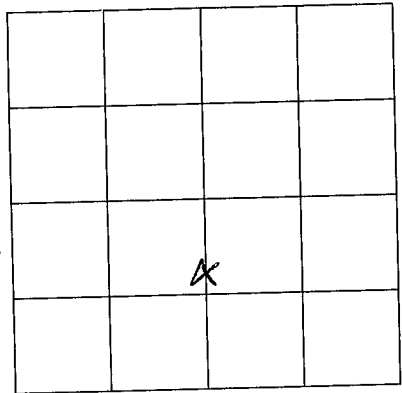

SECTION 17

Please indicate well location X.

ADDITIONAL INFORMATION

If more than one screen,  
show location of each on sketch.