

MISSISSIPPI DEPARTMENT OF ENVIRONMENTAL QUALITY

QUALITY

Office of Land and Water Resources

P. O. Box 10631
Jackson, MS 39289-0631

WATER WELL DRILLERS LOG

COUNTY WELL LOCATED
Washington

WELL NUMBER **A-59** CODED

DATE WELL COMPLETED
6-13-01

33-01-48 91-06-54

PERMIT NUMBER

NAME OF DRILLING FIRM
Schudco Ltd

NAME & MAILING ADDRESS OF LANDOWNER
Fowles Farms Partners

P.O. Box 1955

Oxford Ms 38655

WELL LOCATION. SEC **9** TOWNSHIP **14** RANGE **9**

DISTANCE **4** Miles **West** of **Glen Allen**

OTHER LANDMARK

WELL PURPOSE: Home, **Irrigation**, Municipal, Industrial, Fish Pond, etc.

PUMP DATA

PUMP TYPE (Circle One):
Submersible, **Turbine**, Jet, Flowing Well,
Other (Describe)

POWER TYPE (Circle One):
Electric, Tractor, **Diesel**, Gasoline, Butane,
Other (Describe) H/P **40**

Pump Capacity (GPM) **1500** No. of Stages **1** Setting Depth **60** FT.

PUMP TEST

Well yielded _____ GPM with
a drawdown of _____ ft.
after _____ hours of pumping

WELL DATA

Well Depth **98** Casing Diameter (In.) **16** Casing Length (Ft.) **78**

Type of Casing **pvc** Hole Depth **100** Depth to Static Water Level **12**

TYPE OF COMPLETION: (Circle One or More):
Gravel Packed, Underreamed, Telescoped,
Natural Development, Open Hole, Other

LOG DATA

TYPE OF LOG RUN (Circle One): **No Log Run**
Electric, Gamma Ray, Density, Sonic, Neutron,
Other (Describe)

Name of Organization Running Log

GEOLOGIC DATA (Office Use Only)

| | | | |
|---------------|---------------|----------------|--------------|
| Surface Elev. | Geologic Unit | Unit Thickness | Depth to Top |
| Subs. SWL | Date | Analysis | Aquifer Test |

WELL GROUTED TO A DEPTH OF _____ FEET
Type Grout (circle one): Cement, Bentonite, or Mix

SCREEN DATA

Diameter - Inches **16** Length - Feet **20** Slot Size - Inches **.032**

Screen Type **pvc** Depth to Bottom - Feet **98**

Driller's Remarks

Top of Lap Pipe or Reduction in Casing

FEET IF TELESCOPED OR MORE THAN ONE SCREEN: USE BACK PAGE


| DESCRIPTION OF FORMATIONS ENCOUNTERED | FROM | TO |
|---------------------------------------|------|-----|
| Top soil | 0 | 3 |
| med to fine sand | 3 | 60 |
| med sand | 60 | 80 |
| course sand | 80 | 98 |
| p-gravel clay | 98 | 100 |

| FORMATIONS (Continued) | FROM | TO |
|------------------------|------|----|
| | | |
| | | |
| | | |
| | | |

REC'D SEP 07 2001

If well telescopes please sketch and show depths.

GROUND LEVEL

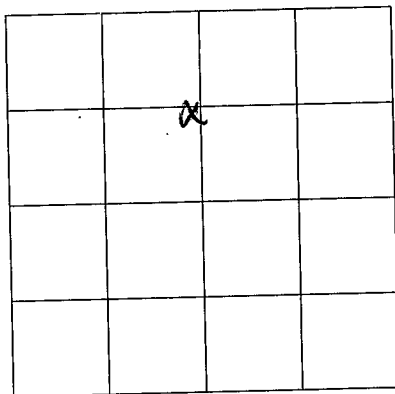

SECTION 9

Please indicate well location X.

ADDITIONAL INFORMATION

If more than one screen,
show location of each on sketch.