

Washington
 Reed
 9-15-76

MISSISSIPPI
 BOARD OF WATER COMMISSIONERS
 416 North State Street
 Jackson, Mississippi 39201

15I

WATER WELL DRILLERS LOG

15 Sept 1976 Lombard Drilling Wash
 date well completed firm name county well located

2
 0
 feet a
 day more
 than

LANDOWNER:
Sam Paudegrass
Alan Keller
 (mailing address)

WELL LOCATION:
 sec. 3 T 14 N R 9 E
 8 W
 3 miles W of Alan Keller
 (distance) (direction) (nearest town)

WELL PURPOSE: home
 (home, irrigation, municipal, industrial)

WELL COMPLETION DATA:

- (1) diameter (inches) 4x2
 - (2) total depth (feet) 760
 - (3) static water level (feet) 36 below
 top of ground. above
 - (4) casing steel, 740,
 (material) (depth)
4x2 If telescope see back.
 (size)
 - (5) screen ~~8800~~, 760-740
 (length) (depth to top)
2, SS
 (size) (material)
 - (6) pump 2 30
 (HP) (yield gpm)
elect
 (type power)
 - (7) electric log
 (yes or no)
- (organization running log)
- (8) how well bottom plugged
back wash

description of formations encountered	depth	
	from	to
Mixed	0	20
Sand	20	60
Sand gravel	60	115
Clay	115	210
Clay sh. Sand	210	440
Sand & Clay	440	600
Rock	600	601
Clay	601	660
Sand - fine	660	720
Sand. good.	720	770

RECEIVED
 OCT 18 1976
 MISS. BD. OF WATER COMMISSIONERS

DRILLERS REMARKS:

If well telescopes please sketch and show depths.

GROUND LEVEL

168 4''


—

572 2''

—

20 55'

260

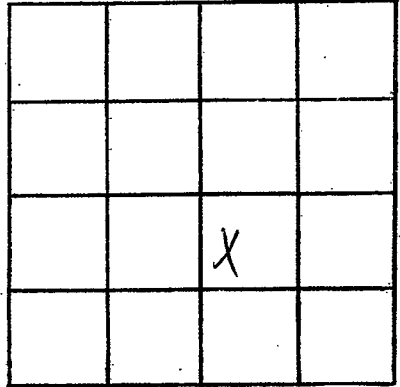

SECTION 3

Please indicate well location X.

ADDITIONAL INFORMATION

If more than one screen, show locations of each on sketch.