

MISSISSIPPI DEPARTMENT OF NATURAL RESOURCES
Bureau of Land and Water Resources
 Southport Mall
 P.O. Box 10631
 Jackson, Mississippi 39209
WATER WELL DRILLERS LOG

Washington
R 2001

4-23 1982 Schultz Drilling Wash.
 date well completed firm name county well located

LANDOWNER: Henry Cooper
Glen Allen, MS
 (mailing address)

WELL LOCATION:
 sec. 25 T. 14 N. R. 9 E.
5 miles NW of Glen Allen
 (distance) (direction) (nearest town)

WELL PURPOSE: Home
 (home, irrigation, municipal, industrial)

- WELL COMPLETION DATA:
- (1) diameter (inches) 4" X 2"
 - (2) total depth (feet) 820'
 - (3) static water level (feet) 31' below above top of ground.
 - (4) casing PVC 800'
 (material) (depth)
 - if telescope see back.
 (size)
 - (5) screen 20' 800'
 (length) (depth to top)
 - 2" PVC Wrapped
 (size) (material)
 - (6) pump 1 19
 (HP) (yield gpm)
 - EIE.
 (type power)
 - (7) electric log NO
 (yes or no)
 - (organization running log)
 - (8) how well bottom plugged b/w

description of formations encountered	depth	
	from	to
SANDY Topsoil	0	20
SANDY Clay	20	100
SAND + gravel	100	120
Clay	120	160
SANDY clay	160	360
SAND	360	440
SANDY clay	440	540
SAND + clay	540	580
Clay	580	640
SANDY Clay	640	740
SAND	740	820

DEPT. OF NATURAL RESOURCES
 BUREAU OF LAND & WATER RESOURCES



MAY 14 1982

RECEIVED

DRILLERS REMARKS:



If well telescopes please sketch and show depths.

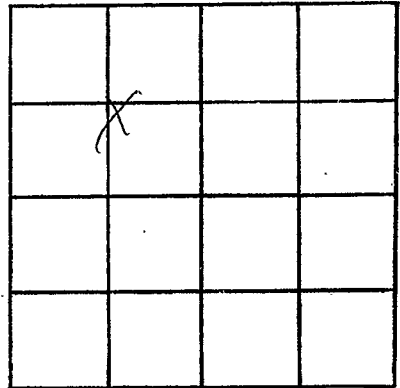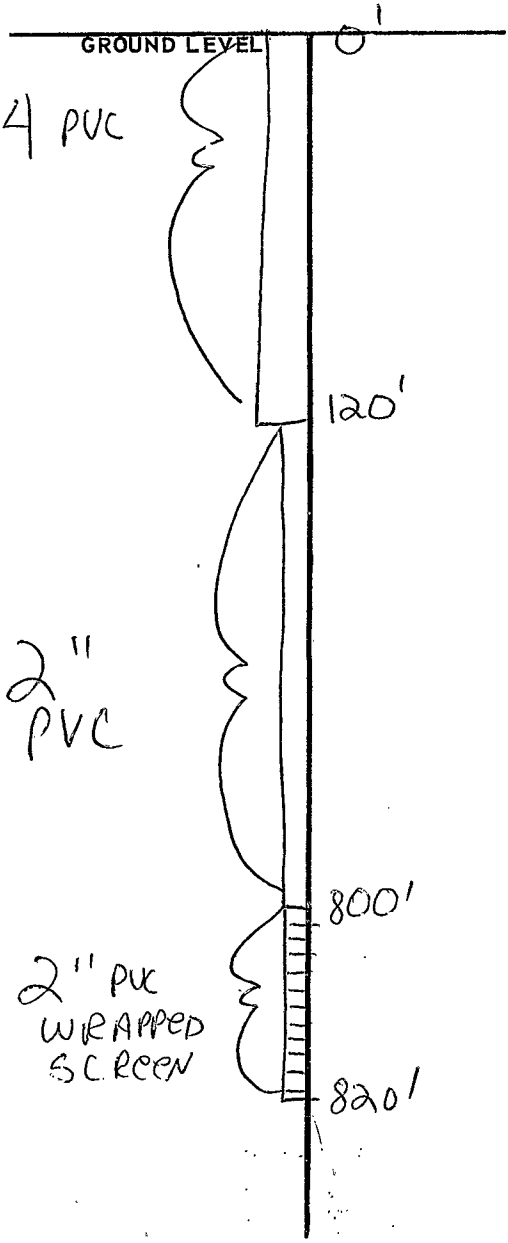

SECTION _____

Please indicate well location X.

ADDITIONAL INFORMATION

A series of 18 horizontal lines for providing additional information.

If more than one screen, show locations of each on sketch.