

Washington
5
6-67

MISSISSIPPI
BOARD OF WATER COMMISSIONERS
416 North State Street
Jackson, Mississippi 39201

WATER WELL DRILLERS LOG

6-8 1967 Bailey Dily. Co Washington
date well completed firm name county well located

LANDOWNER: W.C. Woodruff
Grace Miss.
P.O. Box 126
(mailing address)

description of formations encountered	from	to
Clay	0	20
Sand	20	110
Gravel	110	210
Mud	210	700
Sand	700	760
Mud	760	937

WELL LOCATION:
sec. 31 T. 14 N R. 7 E
2 miles North of Grace
(distance) (direction) (nearest town)


WELL PURPOSE:
(home, irrigation, municipal, industrial)

WELL COMPLETION DATA:

- (1) diameter (inches) 4" x 3"
- (2) total depth (feet) 937
- (3) static water level (feet) _____ below above top of ground.
- (4) casing Blk steel 907
(material) (depth)
_____ if telescope see back.
(size)
- (5) screen 30-3" 907
(length) (depth to top)
3" Stainless steel
(size) (material)
- (6) pump 1 20
(HP) (yield gpm)
Electric
(type power)
- (7) electric log no
(yes or no)

(organization running log)
- (8) how well bottom plugged Back pressure valve

DRILLERS REMARKS:

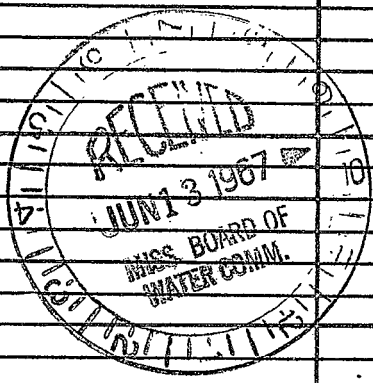

If well telescopes please sketch and show depths.

GROUND LEVEL

4"

2.10 ft.

8"

2.99 ft.

2.0 ft

3" strainer

If more than one screen, show locations of each on sketch.

			X

SECTION 31

Please indicate well location X.

ADDITIONAL INFORMATION

Multiple horizontal lines for additional information.