

WASH. MISSISSIPPI BOARD OF WATER COMMISSIONERS

S62
9-27-56

WATER WELL DRILLERS LOG

CODED

11/15/65
page 302

Date: Sept. 27, 19 56, Driller: Layne-Central Company County Washington

(Name)

- (1) Owner of Land: L. O. Patton
(Name)
Hollandale, Mississippi
(Address)
- (2) Location: 3 148 1/4, 1/4, Sec. 7 T. 17 R. 7
1 miles south of Footo
(distance) (direction) (Nearest Town)
- (3) Topography: flat
(Hilly) (Flat) (Level)
- (4) Purpose of Well: irrigation
(Domestic Irrigation, Municipal, Industrial, Other)

Description & Color of Materials Sand, Clay, Red Clay, Shell, etc.	Thick- ness Feet	Depth Feet
Made soil	8	8
Clay	20	28
Clay & fine blue sand	4	32
Fine blue sand	10	42
Coarse blue sand	10	52
Hard strick sand	3	55
Coarse sand	5	60
Fine sand & clay	5	65
Coarse sand & clay balls	7	72
Blue clay	6	78
Sand & pea gravel	24	102
Sand & gravel	6	108
Med. sand	4	112
Coarse sand & gravel	10	122
Sand & gravel	10	132

Information upon completion of well:

- (1) Diameter 12 inches.
- (2) Total Depth 132 feet.
- (3) Water Level 20' - 4" feet below top of ground.
- (4) Cased to 80', Size 12"
- (5) Screen: Size 12", Length 50'
- (6) Were any formations sealed against pollution?
_____ yes, no no.

If YES depth of formation _____


Why _____

Drillers Remarks: _____

1800 GPM

engine drive

CODED

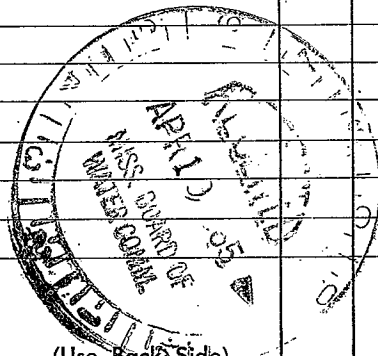

(Use Back Side)

Well No.

1911

1. The first part of the report deals with the general situation of the country and the progress of the work during the year. It is divided into two main sections, the first of which deals with the general situation and the second with the progress of the work.

2. The general situation of the country is described in the first section. It is found that the country is generally prosperous and that the progress of the work is satisfactory. The second section deals with the progress of the work during the year. It is found that the work has been carried out in accordance with the plan and that the results are satisfactory.

3. The second part of the report deals with the details of the work. It is divided into three main sections, the first of which deals with the general situation of the work, the second with the progress of the work, and the third with the results of the work.

4. The general situation of the work is described in the first section. It is found that the work is generally well advanced and that the progress is satisfactory. The second section deals with the progress of the work during the year. It is found that the work has been carried out in accordance with the plan and that the results are satisfactory.

5. The results of the work are described in the third section. It is found that the work has been carried out in accordance with the plan and that the results are satisfactory. The work has been carried out in accordance with the plan and the results are satisfactory.