

S64
4-18-62

WATER WELL DRILLERS LOG


Date: 4/18, 1962, Driller Bailey Drilling Co County Washington
(Name)

(1) Owner of Land:	Description & Color of Materials Sand, Clay, Red Clay, Shell, etc.	Thick- ness Feet	Depth Feet
<u>R. D. Fisher</u> (Name)	<u>Sand</u>	<u>93</u>	<u>93</u>
<u>Glen Allan</u> (Address)	<u>Gravel</u>	<u>4</u>	<u>97</u>
(2) Location: <u>1/4</u> , <u>1/4</u> , Sec. <u>4</u> T. <u>R.</u>	<u>Mud</u>	<u>67</u>	<u>164</u>
<u>3</u> miles <u>N</u> , <u>Glen Allan</u> (distance) (direction) (Nearest Town)	<u>Sand</u>	<u>205</u>	<u>369</u>
(3) Topography: <u>Flat</u> (Hilly) (Flat) (Level)	<u>Sand + Mud</u>		<u>430</u>
(4) Purpose of Well: <u>Domestic</u> (Domestic Irrigation Municipal, Industrial, Other)	<u>Mud</u>		<u>687</u>
	<u>Sand</u>		<u>697</u>
	<u>Mud</u>		<u>760</u>
	<u>Sand</u>		<u>774</u>
	<u>Mud</u>		<u>789</u>
	<u>Sand</u>		<u>800</u>
	<u>Mud - hard</u>		<u>822</u>
	<u>Sand</u>		<u>858</u>

Information upon completion of well:

- (1) Diameter 4 X 3 inches.
- (2) Total Depth 858 feet.
- (3) Water Level 16 feet below top of ground.
- (4) Cased to all way, Size 4 X 3.
- (5) Screen: Size 3", Length 30ft.
- (6) Were any formations sealed against pollution?
no.

If YES depth of formation _____
Why _____
Drillers Remarks: _____

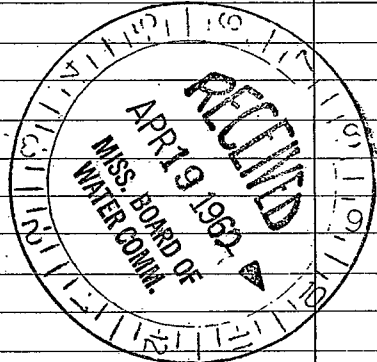

(Use Back Side)

Well No.

