

S65  
5-9-65

WATER WELL DRILLERS

**CODED**

9/17/65  
C 391

Date: May 9, 1965, Driller: Layne-Central Company County Washington

(Name)

(1) Owner of Land: Marathon Plantation  
(Name)

Glenn Allen, Mississippi  
(Address)

(2) Location: 1/4, 1/4, Sec. 7 T14R8

3 miles north, of Glen Allen  
(distance) (direction) (Nearest Town)

(3) Topography: flat  
(Hilly) (Flat) (Level)

(4) Purpose of Well: irrigation  
(Domestic Irrigation  
Municipal, Industrial, Other)

Description & Color of Materials Sand, Clay, Red Clay, Shell, etc.	Thick- ness Feet	Depth Feet
Clay	25	25
Sandy clay	45	70
Coarse sand & pea rock	12	82
Pea rock & sand	10	92
Sand & gravel	10	102
Sand & gravel & pea rock	8	110

Information upon completion of well:

(1) Diameter 12 inches.

(2) Total Depth 110 feet.

(3) Water Level 17' 4" feet below top of ground.

(4) Cased to 70', Size 12"

(5) Screen: Size 12", Length 40'

(6) Were any formations sealed against pollution?

no yes, no no.

If YES depth of formation \_\_\_\_\_


Why \_\_\_\_\_

Drillers Remarks: \_\_\_\_\_

2490 GPM.

Engine Drive.

**CODED**

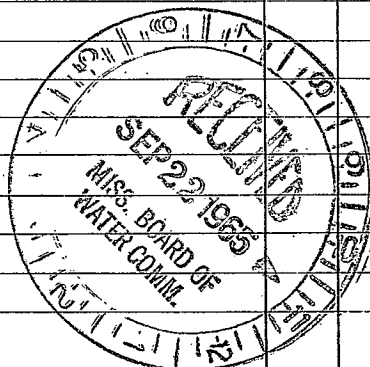

(Use Back Side)

Well No.

