

CODED

Washington  
S 67  
P-28-68

MISSISSIPPI  
BOARD OF WATER COMMISSIONERS  
416 North State Street  
Jackson, Mississippi 39201

WATER WELL DRILLERS LOG

8/28 1968 Bailey Drilling Co. Washington  
date well completed firm name county well located

LANDOWNER:  
Yazoo Wild Life Refuge  
Hollandale, Miss.  
(mailing address)

description of formations encountered	from	to
	Clay	0
Sand	30	40
Gravel	40	100


WELL LOCATION:  
sec 28 T 14 N R 8 E  
4 miles NE of Glen Allan  
(distance) (direction) (nearest town)

WELL PURPOSE: Irrigation  
(home, irrigation, municipal, industrial)

WELL COMPLETION DATA:

- (1) diameter (inches) 6"
  - (2) total depth (feet) 100
  - (3) static water level (feet) 14 below top of ground.
  - (4) casing steel  
(material) (depth)  
6" if telescope see back.  
(size)
  - (5) screen 30' 70'  
(length) (depth to top)  
6" stainless steel  
(size) (material)
  - (6) pump 15 300  
(HP) (yield gpm)  
Elec  
(type power)
  - (7) electric log No  
(yes or no)
- (organization running log)

Please send some envelopes

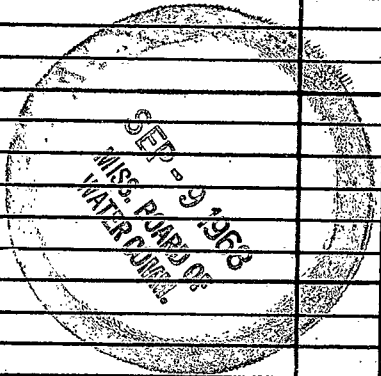

(8) how well bottom plugged:  
Back pressure valve

DRILLERS REMARKS:

