

WASH.  
S 69  
7-21-61

MISSISSIPPI BOARD OF WATER COMMISSIONERS

WATER WELL DRILLERS LOG

9  
CODED

Date: July 21, 19 61, Driller: Layne-Central Company County Washington

(Name)

(1) Owner of Land: <u>Yazoo National Wildlife</u> (Name) <u>Refuge</u>	Description & Color of Materials Sand, Clay, Red Clay, Shell, etc.	Thick- ness Feet	Depth Feet
<u>Hollandale, Mississippi</u> (Address)	Clay	29	29
(2) Location: <u>1/4</u> , <u>1/4</u> , Sec. <u>22</u> <u>14 N 7 W</u> T <u>R</u>	Fine sand	11	40
<u>6</u> miles <u>northeast</u> , of <u>Glen Allen</u> (distance) (direction) (Nearest Town)	Coarse sand	32	72
(3) Topography: <u>flat</u> (Hilly) (Flat) (Level)			
(4) Purpose of Well: <u>irrigation</u> (Domestic Irrigation Municipal, Industrial, Other)			


Information upon completion of well:

- (1) Diameter 2 inches.
- (2) Total Depth 72 feet.
- (3) Water Level 18 feet below top of ground.
- (4) Cased to 62', Size 2"
- (5) Screen: Size 2", Length 10'
- (6) Were any formations sealed against pollution?  
no yes, no no.

If YES depth of formation \_\_\_\_\_

Why \_\_\_\_\_

Drillers Remarks: \_\_\_\_\_

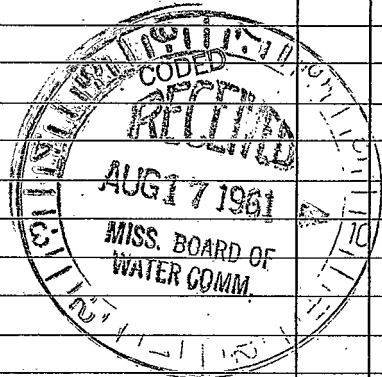

Insuff. info.  
to locate

(Use Back Side)

Well No.

