

Washington
570
10-66

MISSISSIPPI BOARD OF WATER COMMISSIONERS

CODED

WATER WELL DRILLERS LOG

Date: 10/8, 1966, Driller: Bailey Drilling Co County: Washington
PO Box 5335, Greenville, Miss.

(1) Owner of Land: Lewis Cummings
 (Name)
Hampton, Miss.
 (Address)
30 14N 7
 (2) Location: NW 1/4, NW 1/4, Sec. 8
7 1/2 NW 1/4
W miles E of Glen Allen
 (distance) (direction) (Nearest Town)
 (3) Topography: Flat
 (Hilly) (Flat) (Level)
 (4) Purpose of Well: Domestic
 (Domestic Irrigation
 Municipal, Industrial, Other)

Description & Color of Materials Sand, Clay, Red Clay, Shell, etc.	Thick- ness Feet	Depth Feet
Clay	20	20
Sand	60	80
Gravel	20	100
Mud	420	520
Sand	40	560
Mud	68	628
Rock	1	629
Mud	7	636
Rock	1	637
Mud	82	719
Sand	15	734
Mud	72	806
Mud + Sand	8	814
Mud	12	826
Rock	1/2	826 1/2
Mud	926	919
Sand	47	966


Information upon completion of well:

(1) Diameter 4 X 2 inches.
 (2) Total Depth 966 feet.
 (3) Water Level 17 feet below top of ground.
 (4) Cased to all way Size 4 X 2.
 (5) Screen: Size 2", Length 20'.
 (6) Were any formations sealed against pollution?
 _____ yes, X no.

If YES depth of formation _____
 Why _____
 Drillers Remarks: _____

CODED

Location ?

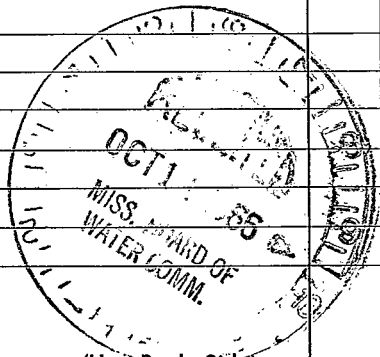

±107'

(Use Back Side)

Well No.

1000

