

S 71

3-5-65

WATER WELL DRILLERS LOG

CODED

Date: 3/5, 1965, Driller: Bailey Drilling Co County: Washington

(Name)

(1) Owner of Land: Stone Bros  
(Name)  
Chatham, Miss  
(Address)

Description & Color of Materials  
Sand, Clay, Red Clay, Shell, etc.

Thick-  
ness  
Feet

Depth  
Feet

Clay  
Sand

125  
160

(2) Location: 1/4, 1/4, Sec. T R

4 miles N of Glen Allen  
(distance) (direction) (Nearest Town)

(3) Topography: Flat  
(Hilly) (Flat) (Level)

(4) Purpose of Well: Domestic  
(Domestic Irrigation  
Municipal, Industrial, Other)

Information upon completion of well:

(1) Diameter 2 inches.

(2) Total Depth 160 feet.

(3) Water Level 15 feet below top of ground.

(4) Cased to all way size 2

(5) Screen: Size 2, Length 5 ft

(6) Were any formations sealed against pollution?

yes, X no.


If YES depth of formation

Why

Drillers Remarks:

CODED

Look up  
to locate

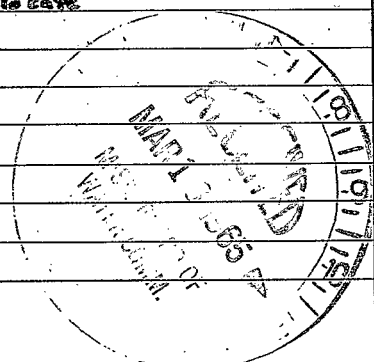

(Use Back Side)

Well No.

