

S 72

2-25-65

WATER WELL DRILLERS LOG

Date: 2/25, 1965, Driller: Bailey Drilling Co. County: Washington
(Name)


(1) Owner of Land: <u>E E Triplett</u> <small>(Name)</small>	Description & Color of Materials Sand, Clay, Red Clay, Shell, etc.	Thick- ness Feet	Depth Feet
<u>Glen Allen, Miss.</u> <small>(Address)</small>	<u>Clay</u>		<u>4</u>
	<u>Sand</u>		<u>80</u>
(2) Location: <u>32 15N 8W</u> <u>1/4</u> , <u>1/4</u> , Sec. <u>T. R.</u>	<u>Mud</u>		<u>260</u>
<u>4</u> miles <u>N</u> of <u>Glen Allen</u> <small>(distance) (direction) (Nearest Town)</small>	<u>Sand</u>		<u>300</u>
(3) Topography: <u>Flat</u> <small>(Hilly) (Flat) (Level)</small>	<u>Mud</u>		<u>784</u>
(4) Purpose of Well: <u>Domestic</u> <small>(Domestic Irrigation Municipal, Industrial, Other)</small>	<u>Sand</u>		<u>895</u>

Information upon completion of well:

- (1) Diameter 4 x 2 1/2 x 2 inches.
- (2) Total Depth 889 feet.
- (3) Water Level 24 feet below top of ground.
- (4) Cased to all way, Size 4 x 2 1/2 x 2
- (5) Screen: Size 2, Length 15 ft.
- (6) Were any formations sealed against pollution?
 yes, no.

CODED

Insuff. info.
to locate.

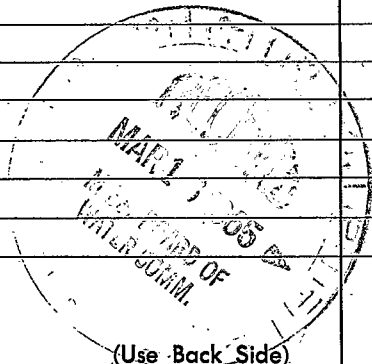

Well No.

