

S 73

CODED

10-19-62


WATER WELL DRILLERS LOG

Date: 10/19, 1962, Driller: Boiley Drilling Co. County Washington
 (Name)

(1) Owner of Land: <u>Francis W Stevens</u> (Name)	Description & Color of Materials Sand, Clay, Red Clay, Shell, etc.	Thick- ness Feet	Depth Feet
<u>Glen Allan, Miss.</u> (Address)	<u>Sand</u>	<u>10</u>	<u>10</u>
(2) Location: <u>1/4, 1/4, Sec. 5 14N8W</u> T. R.	<u>Gravel + Sand</u>		<u>30</u>
<u>3</u> miles <u>north</u> , of <u>Glen Allan</u> (distance) (direction) (Nearest Town)	<u>Mud</u>		<u>202</u>
(3) Topography: <u>Flat</u> (Hilly) (Flat) (Level)	<u>Rock</u>		<u>205</u>
(4) Purpose of Well: <u>Domestic</u> (Domestic Irrigation Municipal, Industrial, Other)	<u>Mud</u>		<u>241</u>
Information upon completion of well:	<u>Rock</u>		<u>243</u>
(1) Diameter: <u>2 1/2 x 2</u> inches.	<u>Mud</u>		<u>524</u>
(2) Total Depth: <u>860</u> feet.	<u>Rocks</u>		<u>527</u>
(3) Water Level: <u>12</u> feet below top of ground.	<u>Sand + Mud</u>		<u>608</u>
(4) Cased to <u>all way</u> Size <u>2 1/2 x 2</u>	<u>Rock</u>		<u>607</u>
(5) Screen: Size <u>2</u> , Length <u>15 ft</u>	<u>Mud</u>		<u>620</u>
(6) Were any formations sealed against pollution? <u>yes</u> , <u>X</u> no.	<u>Rock</u>		<u>621</u>
If YES, depth of formation _____	<u>Mud</u>		<u>697</u>
Why _____	<u>Sand + Mud</u>		<u>717</u>
Drillers Remarks: _____	<u>Rock</u>		<u>794</u>
_____	<u>Sand</u>		<u>795</u>
_____			<u>860</u>

CODED

Insuff. info.
to locate

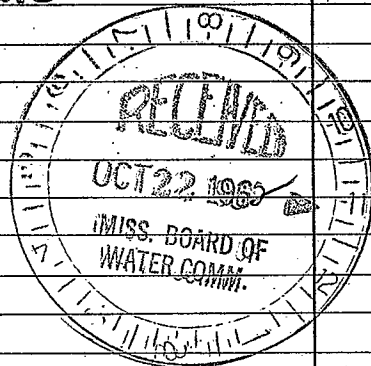

(Use Back Side)

Well No.

[The page contains extremely faint and illegible text, likely bleed-through from the reverse side of the document. No specific words or phrases can be discerned.]