

WASH.

MISSISSIPPI BOARD OF WATER COMMISSIONERS

S 74

8-16-62

WATER WELL DRILLERS LOG

CODED

Date: 8/16, 1962, Driller: Bailey Drilling Co. County: Washington

(1) Owner of Land: <u>Bob Cainsworth</u> (Name) <u>Hollandale, Miss.</u> (Address)	Description & Color of Materials Sand, Clay, Red Clay, Shell, etc.	Thick- ness Feet	Depth Feet
	<u>Clay</u>	<u>30</u>	<u>30</u>
	<u>Sand</u>	<u>61</u>	<u>91</u>
(2) Location: <u>29 14 N 8 W</u> 1/4, 1/4, Sec. T R			
<u>3</u> miles <u>East</u> , of <u>Glen Allen</u> (distance) (direction) (Nearest Town)			
(3) Topography: <u>Flat</u> (Hilly) (Flat) (Level)			
(4) Purpose of Well: <u>Domestic</u> (Domestic Irrigation Municipal, Industrial, Other)			

Information upon completion of well:

- (1) Diameter 2 inches.
- (2) Total Depth 91 feet.
- (3) Water Level 21 feet below top of ground.
- (4) Cased to all way Size 2
- (5) Screen: Size 2" Length 5'
- (6) Were any formations sealed against pollution?


CODED

yes, no.

If YES depth of formation _____
Why _____

Drillers Remarks: _____

Insuff. info. to locate

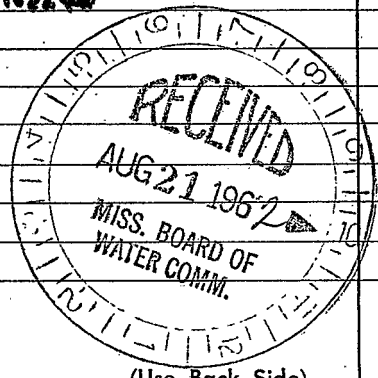

(Use Back Side)

Well No.

[The page contains extremely faint and illegible text, likely bleed-through from the reverse side of the document. The text is too light to transcribe accurately.]