

5/17/67
[Signature]
 22419

Washington
 STS
 4-13-67

MISSISSIPPI
 BOARD OF WATER COMMISSIONERS
 416 North State Street
 Jackson, Mississippi 39201

WATER WELL DRILLERS LOG

April 13, 1967 Layne-Central Company Washington
 date well completed firm name county well located

LANDOWNER: J. C. Willis, Jr.

Hollandale, Mississippi

(mailing address)

description of formations encountered

from to

Clay	0	16
Sand	16	41
Coarse sand, pea gravel	41	78
Coarse sand, gravel	78	122

WELL LOCATION:

sec. S 14 N R 7 E
 S W

10 miles SW of Hollandale
 (distance) (direction) (nearest town)

WELL PURPOSE: irrigation
 (home, irrigation, municipal, industrial)

WELL COMPLETION DATA:

(1) diameter (inches) 16
 (2) total depth (feet) 122
 (3) static water level (feet) 119 ^{feet} below top of ground.

(4) casing steel, 72'
 (material) (depth)
16# If telescope see back.
 (size)


(5) screen 50', 122'
 (length) (depth to top)
16#, Armco
 (size) (material)

(6) pump 70, 3430
 (HP) (yield gpm)
engine
 (type power)

(7) electric log no
 (yes or no)
 (organization running log)

(8) how well bottom plugged plate

DRILLERS REMARKS:

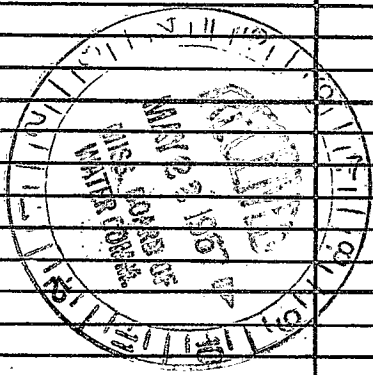

If well telescopes please sketch and show depths.

GROUND LEVEL

SECTION _____

Please indicate well location X.

ADDITIONAL INFORMATION

If more than one screen,
show locations of each on sketch.