

Washington
576
6-12-68

MISSISSIPPI
BOARD OF WATER COMMISSIONERS
416 North State Street
Jackson, Mississippi 39201

7/23/68
Jm
2672

WATER WELL DRILLERS LOG

June 12, 19 68 Layne-Central Company Washington
date well completed firm name county well located

LANDOWNER: Bob Ainsworth & Son	description of formations encountered	from	to
	Clay balls	20	38
Hollandale, Mississippi (mailing address)	Coarse sand	38	50
	Coarse sand, pea gravel	50	95
WELL LOCATION:	Coarse sand, gravel	95	108
sec 29 T 14 N R 8 E W	Boulders	108	110
13 miles SW of Hollandale (distance) (direction) (nearest town)			
WELL PURPOSE: irrigation (home, irrigation, municipal, industrial)			
WELL COMPLETION DATA:			
(1) diameter (inches) 16			
(2) total depth (feet) 110			
(3) static water level (feet) 15' below top of ground.			
(4) casing steel 60' (material), (depth)			
16" (size) if telescope see back.			
(5) screen 50' (length), 110' (depth to top)			
16" (size), Armco (material)			
(6) pump 2400 (HP) (yield gpm)			
engine (type/power)			
(7) electric log no (yes or no)			
(organization running log)			
(8) how well bottom plugged plate			

MISSISSIPPI
COMMISSIONERS
OF WATER


MISSISSIPPI
COMMISSIONERS
OF WATER

MISSISSIPPI
COMMISSIONERS
OF WATER

DRILLERS REMARKS:

If well telescopes please
sketch and show depths.

GROUND LEVEL

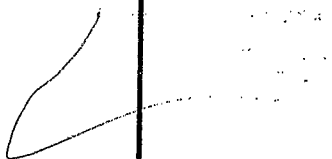

SECTION _____

Please indicate well location X.

ADDITIONAL INFORMATION

If more than one screen,
show locations of each on sketch.