

CODED

10/20/70
JW

MISSISSIPPI
BOARD OF WATER COMMISSIONERS
416 North State Street
Jackson, Mississippi 39201

WATER WELL DRILLERS LOG

C3299

WASHINGTON
S 77
9-25-70

September 25, 1970 SINGER-Layne Central Division Washington
date well completed firm name county well located

LANDOWNER: A. D. Worthington

description of fomations encountered

from to

Clay	0	9
Sand	9	70
Gravel	70	102
Big gravel	102	150
Sandy shale	150	180
Clay	180	240
Sandy shale	240	309
Coarse sand	309	440
Sandy shale	440	478
Hard clay	478	616
Rock	616	617
Fine sand	617	630
Shale	630	670
Clay	670	766
Sand	766	770
Clay	770	786
Sand	786	794
Hard clay	794	812
Shale	812	843
Rock	843	845
Shale	845	875
Sand	875	950
Shale	950	1000
Sand	1000	1088

Glen Allan, Mississippi
(mailing address)

WELL LOCATION:

sec. 15 T. 14 N R. 8 xxx
xxx W
Glen Allan
(distance) miles (direction) of (nearest town)

WELL PURPOSE: home
(home, irrigation, municipal, industrial)

WELL COMPLETION DATA:

- (1) diameter (inches) 4 x 2
- (2) total depth (feet) 955'
- (3) static water level (feet) 32' 10" below top of ground. ~~xxx~~
- (4) casing steel 802' (material) (depth)
4" & 2" if telescope see back. (size)
- (5) screen 30' 937' (length) (depth to top)
2" stainless steel (size) (material)
- (6) pump 1 HP 20 (HP) (yield gpm)
151' of blank pipe. electric (type power)
- (7) electric log yes (yes or no)
U. S. G. S. (organization running log)

(8) how well bottom plugged 50 lbs. shot

DRILLERS REMARKS:


CODED

OCT 22 1970

MISS. Bd. OF
WATER COMM.

If well telescopes please sketch and show depths.

GROUND LEVEL

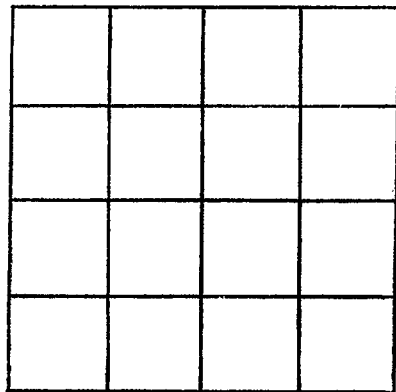

SECTION _____

Please indicate well location X.

ADDITIONAL INFORMATION

If more than one screen,
show locations of each on sketch.