

WASHINGTON
S 79
4-5-72

MISSISSIPPI
BOARD OF WATER COMMISSIONERS
416 North State Street
Jackson, Mississippi 39201

CODED

WATER WELL DRILLERS LOG

4-5 date well completed
Schultz Drilling Co firm name
Wash. county well located

LANDOWNER:	description of formations encountered	from	to
E. E. Woodall Glenn Allen Miss (mailing address)			
WELL LOCATION:	Sand	16	116
sec. 34 T. 14 N. R. 8 E. 3 miles E of GLENN ALLEN (distance) (direction) (nearest town)	Clay	116	183
WELL PURPOSE: Home (home, irrigation, municipal, industrial)	Sandy Shale	183	190
WELL COMPLETION DATA:	Sand	190	203
(1) diameter (inches) 2"	Shale	203	284
(2) total depth (feet) 934	Sand	284	487
(3) static water level (feet) 19 below top of ground.	Clay	487	628
(4) casing PVC (material), (depth) (size) If telescope see back.	Shale + Sand	628	887
(5) screen 10 (length), (depth to top) 2" (size), S.S. (material)	Sand	887	949
(6) pump 1 (HP), 10 (yield gpm)			
(7) electric log (yes or no) No			
(organization running log)			
(8) how well bottom plugged			
DRILLERS REMARKS:			


CODED

JUN 10 1972

MISSISSIPPI BOARD OF WATER COMMISSIONERS

If well telescopes please sketch and show depths.

GROUND LEVEL

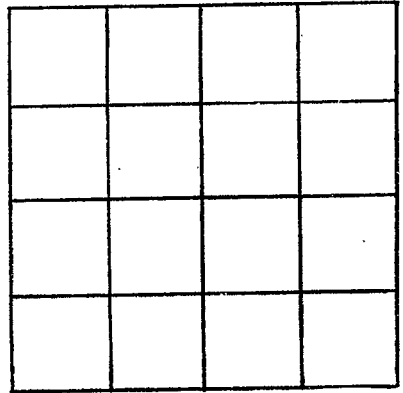

SECTION _____

Please indicate well location X.

ADDITIONAL INFORMATION

A series of horizontal lines for recording additional information, starting below the 'ADDITIONAL INFORMATION' header and extending to the bottom of the page.

If more than one screen, show locations of each on sketch.