

Washington
580
9-3-71

MISSISSIPPI
BOARD OF WATER COMMISSIONERS
416 North State Street
Jackson, Mississippi 39201

CODED

WATER WELL DRILLERS LOG


9-3 date well completed 1971 Schultz Drilling firm name Washington county well located

LANDOWNER	description of formations encountered	from	to
Joel Middlebrooks	Clay	0	20
Glenn Allen Meier (mailing address)	Sand	20	103
WELL LOCATION: sec. 15 T 14 N R 8 E 1 miles West of Glenn Allen Meier (distance) (direction) (nearest town)	Clay	103	181
WELL PURPOSE: (home, irrigation, municipal, industrial)	Sand	181	363
WELL COMPLETION DATA: (1) diameter (inches) 4x2	Clay Shale	363	365
(2) total depth (feet) 891	Sand	365	443
(3) static water level (feet) 29 below top of ground.	Sand Shale	443	473
(4) casing Gal (material) (depth)	Sand CODED	473	484
if telescope see back.	Shale	484	504
(5) screen 30 (length) 30 (depth to top)	Sand	504	624
2" (size) STAINLESS (material)	Rock	624	625
(6) pump 1 1/2 (HP) 30 (yield gpm)	Sand	625	665
Electric (type power)	Shale	665	705
(7) electric log NO (yes or no)	Shale + Sand Shale	705	848
(organization running log)	Sand	848	909
(8) how well bottom plugged			
DRILLERS REMARKS:			

OCT 8 1971

If well telescopes please sketch and show depths.

GROUND LEVEL

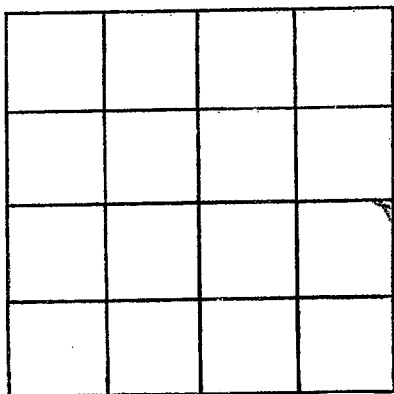

SECTION _____

Please indicate well location X.

ADDITIONAL INFORMATION

If more than one screen, show locations of each on sketch.