

583
 WASHINGTON
 7-3-73

MISSISSIPPI
 BOARD OF WATER COMMISSIONERS
 416 North State Street
 Jackson, Mississippi 39201
 WATER WELL DRILLERS LOG

COPIED 46

July 3, 1973 Singer-Layne Central Div. Washington
 date well completed firm name county well located

LANDOWNER: Mrs. I. M. Jeffrey
 Glen Allan, Miss.

description of formations encountered	depth	
	from	to
Clay	0	14
Sand	14	35
Sand & Gravel	35	96
Hard Clay	96	97

(mailing address)

WELL LOCATION:
 sec. 27 T. 14 N R. 8 E
 S W
 (distance) miles (direction) of (nearest town)

WELL PURPOSE: Irrigation
 (home, irrigation, municipal, industrial)

WELL COMPLETION DATA:


- (1) diameter (inches) 12"
- (2) total depth (feet) 96'
- (3) static water level (feet) 14' below top of ground.
- (4) casing Steel, 56' (material), (depth), 12" (size) if telescope see back.
- (5) screen 40' (length), 96' (depth to top), 12" (size), Armco Iron (material)
- (6) pump 40 (HP), 1500 (yield gpm), Engine (type power)
- (7) electric log No (yes or no)
- (organization running log)
- (8) how well bottom plugged Plate

DRILLERS REMARKS:

AUG 15 1973

If well telescopes please sketch and show depths.

GROUND LEVEL

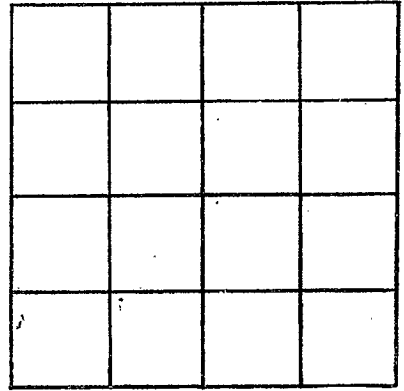

SECTION _____

Please indicate well location X.

ADDITIONAL INFORMATION

If more than one screen,
show locations of each on sketch.