

585
WASHINGTON
5-16-73

MISSISSIPPI
BOARD OF WATER COMMISSIONERS
416 North State Street
Jackson, Mississippi 39201

CODED

WATER WELL DRILLERS LOG

5/16 1973 Schultz Drilling Washington
date well completed firm name county well located

LANDOWNER:	description of formations encountered	from	to
E.E. Woodall			
Glen Allen Miss	slty	0	40
(mailing address)	sand	40	102

WELL LOCATION:
sec. 34 T. 14 N R. 8 E
2 miles S.E. of Glen Allen
(distance) (direction) (nearest town)

WELL PURPOSE: driv
(home, irrigation, municipal, industrial)

- WELL COMPLETION DATA:
- (1) diameter (inches) 4"
 - (2) total depth (feet) 95
 - (3) static water level (feet) 20 below top of ground.
 - (4) casing P.V.C. (material) (depth)
(size) if telescope see back.
 - (5) screen 15 (length) (depth to top)
4" (size) P.V.C. (material)
 - (6) pump 1 1/2 (HP) 45 (yield gpm)
ela (type power)
 - (7) electric log no (yes or no)
(organization running log)
 - (8) how well bottom plugged top plug

CODED


Handwritten notes:
The well was drilled on a...
P.V.C. casing...
The well was drilled on a...
P.V.C. casing...
The well was drilled on a...
P.V.C. casing...

DRILLERS REMARKS:

AUG 28 1973

If well telescopes please sketch and show depths.

GROUND LEVEL

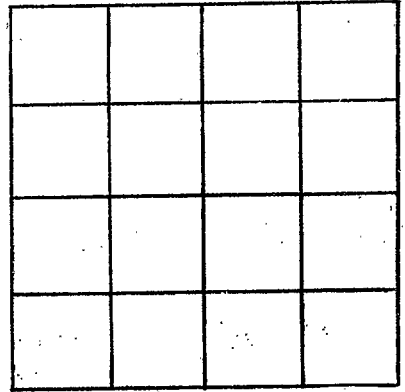

SECTION _____

Please indicate well location X.

ADDITIONAL INFORMATION

If more than one screen, show locations of each on sketch.