

WASHINGTON

S88

6-8-74

F Log # 83

6-8-74 19 date well completed

MISSISSIPPI BOARD OF WATER COMMISSIONERS 416 North State Street Jackson, Mississippi 39201

CODED

WATER WELL DRILLERS LOG

Department Drilling Co. Washington firm name county well located

LANDOWNER:

A. J. Mahalick

Grace Miss

Rollins Park (mailing address) Route 1

WELL LOCATION:

sec. 35 T 14 N R 8 E W

(distance) miles (direction) of (nearest town)

WELL PURPOSE:

(home, irrigation, municipal, industrial)

WELL COMPLETION DATA:

- (1) diameter (inches) 11"
(2) total depth (feet) 940
(3) static water level (feet) 20 below top of ground.
(4) casing steel, 890 (material), (depth)
(5) screen 56ft, 890 (length), (depth to top)
(6) pump 5 (HP), 80 (yield gpm)
(7) electric log yes
(8) how well bottom plugged Stubby

description of formations encountered

from to

Table with 3 columns: description of formations encountered, from, to. Rows include clay top soil, sand, gravel, shale, sandy shale, sand, shale, sand shale with fine sand, shale, sand.

CODED

RECEIVED stamp


JUN 27 1974

DRILLERS REMARKS:

All other wells around in close west 850 and above, 850

If well telescopes please sketch and show depths.

GROUND LEVEL

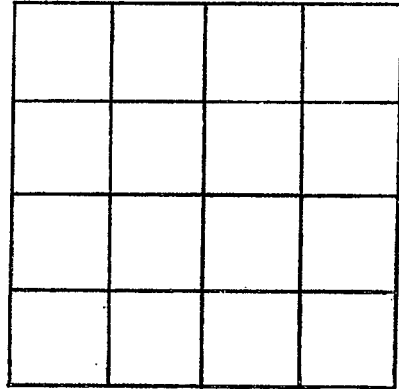

SECTION _____

Please indicate well location X.

ADDITIONAL INFORMATION

A series of horizontal lines providing space for additional information.

If more than one screen, show locations of each on sketch.