

WASH
S 89
9-12-74

MISSISSIPPI
BOARD OF WATER COMMISSIONERS
416 North State Street
Jackson, Mississippi 39201

CODED

WATER WELL DRILLERS LOG

SEPT 12, 74 19 BYER WELL & IRRIGATION SERVICE WASHINGTON
date well completed firm name county well located

LANDOWNER:
LED WILLIAMS # 3
HOLLANDALE, MISS.
(mailing address)

description of formations encountered	from	to
CLAY	0	21
SAND & PEA ROCK	21	46
PEA ROCK, COARSE	46	
SAND & GRAVEL		103

WELL LOCATION:
sec. 9 T. 14 N. R. 7 E
4 miles S.W. of PERCY
(distance) (direction) (nearest town)

WELL PURPOSE: FERT
(home, irrigation, municipal, industrial)

- WELL COMPLETION DATA:
- (1) diameter (inches) 16
 - (2) total depth (feet) 103'
 - (3) static water level (feet) 16' below above top of ground.
 - (4) casing BUETO, 63' (material) (depth)
16" (size) if telescope see back.
 - (5) screen 40' 63' (length) (depth to top)
16" BUZ INGOT (size) (material)
 - (6) pump 60 3000 (HP) (yield gpm)
DIESEL (type power)
 - (7) electric log 1/0 (yes or no)
 - (organization running log)
 - (8) how well bottom plugged PLATE


CODED

RECEIVED
NOV 21 1974

DRILLERS REMARKS:

If well telescopes please sketch and show depths.

GROUND LEVEL

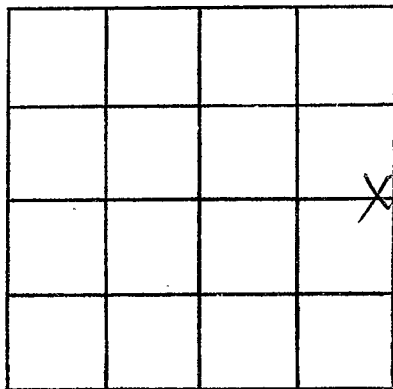

SECTION 9

Please indicate well location X.

ADDITIONAL INFORMATION

If more than one screen, show locations of each on sketch.