

Washington
 9 90
 6-10-75

MISSISSIPPI
 BOARD OF WATER COMMISSIONERS
 416 North State Street
 Jackson, Mississippi 39201
 WATER WELL DRILLERS LOG

CODED

June 10 1975 Bruce Berryman Washington
 date well completed firm name: county well located
 Greenwood, Miss.


LANDOWNER: Crow Farms	description of formations encountered		from	to
P.O. Box 416, Hollandale, Miss. 38748	Sandy clay		0	20
(mailing address)	Sand		20	60
WELL LOCATION:	Sand & gravel		60	100
sec. 31 T 14 N R 8 E 15 I	Clay		100	180
2 1/2 miles EAST of GLEN ALLAN	Sand		180	260
(distance) (direction) (nearest town)	Clay		260	300
WELL PURPOSE: Home	Sand		300	340
(home, irrigation, municipal, industrial)	Sand str. clay		340	360
WELL COMPLETION DATA:	Sand		360	480
(1) diameter (inches) 4" x 2"	Clay		480	540
(2) total depth (feet) 810'	Sand		540	600
(3) static water level (feet) 18 below top of ground	Sandy shale		600	700
(4) casing 4" blk pipe - 126'	Sand		700	740
2" galv. " - 663'	Clay		740	760
(material) (depth)	Shale		760	790
(size) If telescope see back.	Sand		790	810
(5) screen 20' 790'	Clay		810	820
(length) (depth to top)				
.010 stainless steel				
(size) (material)				
(6) pump 2 60				
(HP) (yield gpm)				
electric				
(type power)				
(7) electric log No				
(yes or no)				
(organization running log)				
(8) how well bottom plugged B.P.V				
DRILLERS REMARKS:				

MISS. BD. OF WATER COMM.

2011

If well telescopes please sketch and show depths.

GROUND LEVEL

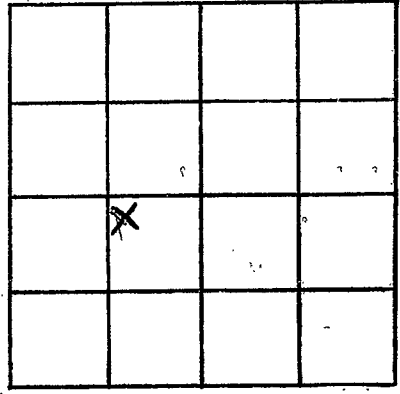

SECTION 3i

Please indicate well location X.

ADDITIONAL INFORMATION

Lined area for additional information.

If more than one screen, show locations of each on sketch.