

Washington  
920  
11-26-74

MISSISSIPPI  
BOARD OF WATER COMMISSIONERS  
416 North State Street  
Jackson, Mississippi 39201  
WATER WELL DRILLERS LOG

CODED

11-26 date well completed      1974 DYER-SULLIVAN INC. firm name      WASHINGTON county well located

LANDOWNER:  
EIFLIN FARMS

description of formations encountered	from	to
CLAY	0	33
FINE SAND	33	73
SAND & GRAVEL	73	113

10017A WPALEJ, MISS.  
(mailing address)

WELL LOCATION:  
sec. S T14N R. 2 E 155  
8 miles NE of Ston Allen  
(distance) (direction) (nearest town)

WELL PURPOSE: TRV.  
(home, irrigation, municipal, industrial)

- WELL COMPLETION DATA:
- (1) diameter (inches) 16"
  - (2) total depth (feet) 113
  - (3) static water level (feet) 11 below above top of ground.
  - (4) casing BULTR, 73'  
(material) (depth)  
16" if telescope see back.  
(size)
  - (5) screen 40', 73'  
(length) (depth to top)  
16", BULTR  
(size) (material)
  - (6) pump 60, 3000  
(HP) (yield gpm)  
DIESEL  
(type power)
  - (7) electric log No  
(yes or no)  
  
(organization running log)
  - (8) how well bottom plugged PLATE

CODED


RECORDED  
INDEXED  
OCT 19 1975

DRILLERS REMARKS:

MISS. BD. OF WATER COMMISSIONERS

If well telescopes please  
sketch and show depths.

GROUND LEVEL

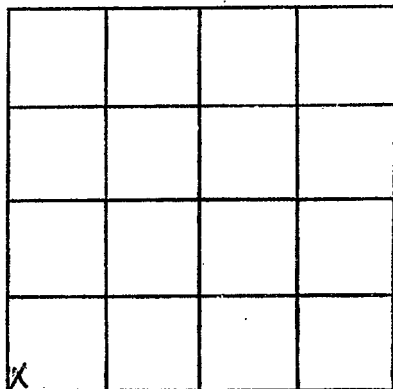

SECTION 5

Please indicate well location X.

ADDITIONAL INFORMATION

If more than one screen,  
show locations of each on sketch.