

MISSISSIPPI
BOARD OF WATER COMMISSIONERS
416 North State Street **CODED**
Jackson, Mississippi 39201

WATER WELL DRILLERS LOG

Washington
S 93
11-30-74

11-30

1970 DYER-SULLIVAN INC.

WASHINGTON

date well completed

firm name

county well located

LANDOWNER:

description of formations encountered

from

to

EVELYN FARMS #2

CLAY

0

33

HOLLANDALE MISS

FINE SAND

33

73

(mailing address)

SAND & GRAVEL

73

113

WELL LOCATION:

sec. 18 T. 14 (N) R. 7 (E) 15E
6 1/2 miles NE of Gen. Allen
(distance) (direction) (nearest town)

WELL PURPOSE: IRRI.

(home, irrigation, municipal, industrial)

WELL COMPLETION DATA:

- (1) diameter (inches) 16"
- (2) total depth (feet) 113'
- (3) static water level (feet) 11' below above top of ground.
- (4) casing Buc. Ir. 73'
(material) (depth)
16" if telescope see back.
(size)
- (5) screen 40' 73'
(length) (depth to top)
16" BUC INBOT
(size) (material)
- (6) pump 60 3200
(HP) (yield gpm)
DIESEL
(type power)
- (7) electric log NO
(yes or no)

(organization running log)
- (8) how well bottom plugged PLUG

CODED


RECEIVED
JUL 18 1975

MISS. Bd. OF WATER COMMISSIONERS

DRILLERS REMARKS:

If well telescopes please
sketch and show depths.

GROUND LEVEL

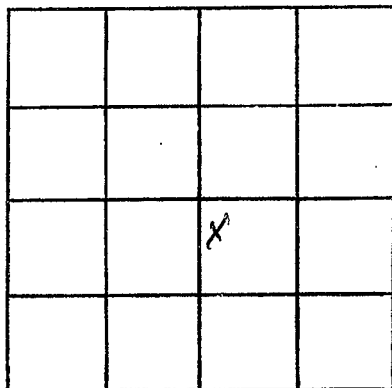

SECTION 18

Please indicate well location X.

ADDITIONAL INFORMATION

If more than one screen,
show locations of each on sketch.