

Washington
 S95
 3/1/78

MISSISSIPPI
 BOARD OF WATER COMMISSIONERS **CODED**
 416 North State Street
 Jackson, Mississippi 39201

WATER WELL DRILLERS LOG

3-1 1978 E.M. "Bud" Cresswell Washington
 date well completed firm name county well located

LANDOWNER:
L.K. Cordell
Glen Allen, MS.
 (mailing address)

description of formations encountered	from	to
<u>Surface deposit</u>	<u>0</u>	<u>10</u>
<u>Dark gravel</u>	<u>10</u>	<u>90</u>

WELL LOCATION: No map
 sec. 31 T. 14 N. R. 8 E.
2 miles EAST of Glen Allen
 (distance) (direction) (nearest town)

WELL PURPOSE:
 (home, irrigation, municipal, industrial)

WELL COMPLETION DATA:

(1) diameter (inches) 4

(2) total depth (feet) 90

(3) static water level (feet) 10 below above-top of ground.

(4) casing Pvc 60
 (material) (depth)
4 if telescope see back.
 (size)

(5) screen 30 60
 (length) (depth to top)
4 PVC
 (size) (material)

(6) pump 15 125
 (HP) (yield gpm)
0
 (type power)

(7) electric log No
 (yes or no)

(organization running log)

(8) how well bottom plugged
Steel plug

DRILLERS REMARKS:

CODED


RECEIVED

MAR 22 1978

MISS. BD. OF WATER COMM.

If well telescopes please sketch and show depths.

GROUND LEVEL

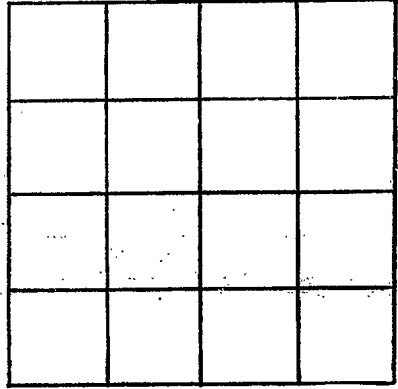

SECTION _____

Please indicate well location X.

ADDITIONAL INFORMATION

If more than one screen,
show locations of each on sketch.