

WASHINGTON
 S96
 7/17/78
 Flwg #
 July 17 1978

MISSISSIPPI
 BOARD OF WATER COMMISSIONERS
 416 North State Street
 Jackson, Mississippi 39201

CODED

WATER WELL DRILLERS LOG

Scholtz Drilling Co. Washington

date well completed firm name county well located

LANDOWNER:	description of formations encountered	from	to
Yazoo National Wildlife Refuge Rt. 1 Box 286; Hollandale MS. (mailing address) 38748			
	Sand + gravel	16	98
	Clay	98	120
	Sandy Shale	120	520
	SAND	520	600
	Sandy Shale	600	710
	Med sand	710	720
	Hard Clay	720	815
	Sand	815	849
WELL LOCATION: sec. 19 T. 15 N. R. 8 E. 6 miles SW of New Allen (distance) (direction) (nearest town)			
WELL PURPOSE: Home (home, irrigation, municipal, industrial)			
WELL COMPLETION DATA:			
(1) diameter (inches) 4" X 2 1/2"			
(2) total depth (feet) 849'			
(3) static water level (feet) 23' below top of ground.			
(4) casing: Black Steel 809' (material) (depth) 4" X 2 1/2" (size) If telescope see back.			
(5) screen 30' (length), 819' (depth to top) 2 1/2" (size), Stainless Steel (material)			
(6) pump 1 1/2 (HP), 30 (yield gpm) elec (type power)			
(7) electric log YES (yes or no) USGS (organization running log)			
(8) how well bottom plugged b/w			
DRILLERS REMARKS:			



CODED

RECEIVED
 MS

DEC 27 1978

If well telescopes please sketch and show depths.

GROUND LEVEL

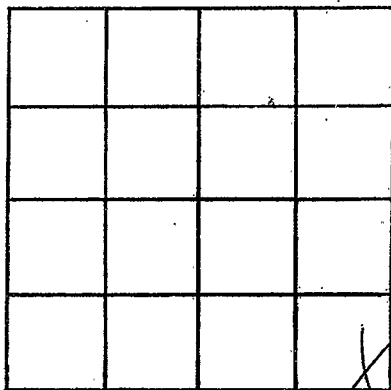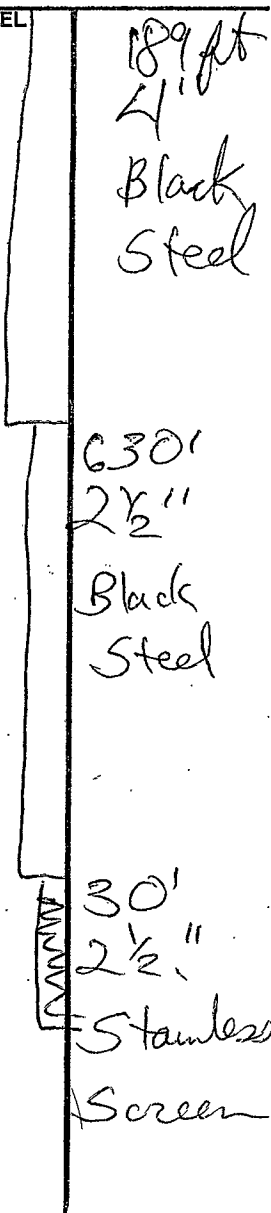

SECTION _____

Please indicate well location X.

ADDITIONAL INFORMATION

Area for providing additional information with horizontal lines.

If more than one screen, show locations of each on sketch.