

WASHINGTON  
 597  
 12/20/78

MISSISSIPPI  
 BOARD OF WATER COMMISSIONERS  
 416 North State Street  
 Jackson, Mississippi 39201

CODED

WATER WELL DRILLERS LOG

12-20-78 19 BUTANE GAS COMPANY Washington  
 date well completed firm name county well located  
 OF GREENWOOD

LANDOWNER:  
 Clyde Nichols  
 Glen Allan  
 (mailing address)

description of formations encountered	from	to
CLAY	0	18
FINE SAND	18	60
COARSE SAND	60	98
GRAVEL	98	120

WELL LOCATION:  
 sec. 8 T 14 N R 8 E  
 S W  
 2 miles E of Glen Allan  
 (distance) (direction) (nearest town)

WELL PURPOSE: IRR  
 (home, irrigation, municipal, industrial)

- WELL COMPLETION DATA:
- (1) diameter (inches) 12"
  - (2) total depth (feet) 120
  - (3) static water level (feet) 15 below top of ground.
  - (4) casing Steel, 100, (material) (depth)  
 12" if telescope see back. (size)
  - (5) screen 20, 100 (length) (depth to top)  
 12" Steel (size) (material)
  - (6) pump 30 1000 (HP) (yield gpm)  
 Diesel (type power)
  - (7) electric log No (yes or no)  
 (organization running log)
  - (8) how well bottom plugged Steel Plate

CODED


RECEIVED  
 DEC 27 1978

MISS. BD. OF WATER COMM.

DRILLERS REMARKS:

If well telescopes please sketch and show depths.

GROUND LEVEL

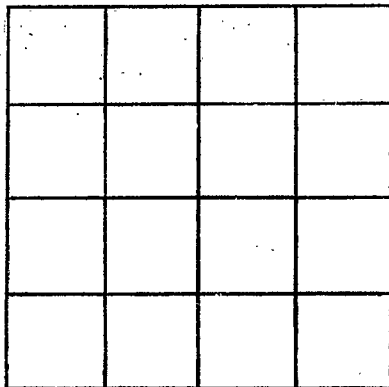

SECTION \_\_\_\_\_

Please indicate well location X.

ADDITIONAL INFORMATION

If more than one screen, show locations of each on sketch.