

Washington
S-98

MISSISSIPPI
BOARD OF WATER COMMISSIONERS
416 North State Street
Jackson, Mississippi 39201

WATER WELL DRILLERS LOG

12-30-79

Dec 30

1979 Coppage Drilling Washington

date well completed

firm name

county well located

LANDOWNER: Jack Middleton

description of formations encountered

from to

(mailing address)

WELL LOCATION:

sec. 13 T 14 N R 2 E
4 miles W of GLEN ALLEN
(distance) (direction) (nearest town)

WELL PURPOSE:
(home, irrigation, municipal, industrial)

WELL COMPLETION DATA:

- (1) diameter (inches) 4-2 1/2 - 2
- (2) total depth (feet) 927
- (3) static water level (feet) 35' below top of ground.
- (4) casing GALV. 927 (material) (depth) 4-2 1/2 - 2 (size) If telescope see back.
- (5) screen 10 927 (length) (depth to top) 2" STEEL (size) (material)
- (6) pump 1 1/2 48 gpm (HP) (yield/gpm) ELECTRIC (type power)
- (7) electric log NO (yes or no)
- (8) how well bottom plugged Jack Middleton

CLAY	0	10
SAND	10	70
GRAVEL + SAND	70	120
Mud	120	210
SAND + Mud	210	230
Rock	230	230.5
Mud	230	260
SAND + Mud	260	600
Rock	600	631
Mud	631	662
Mud + SAND	662	700
SAND (FINE)	700	735
Mud + SAND	735	810
Rock	810	870.5
Mud + SAND	870.5	890
SAND	890	927

DEPT. OF NATURAL RESOURCES
BUREAU OF LAND & WATER RESOURCES

JAN 7 1980


RECEIVED

DRILLERS REMARKS:

PER GRAVEL WITH HELL.

If well telescopes please sketch and show depths.

GROUND LEVEL

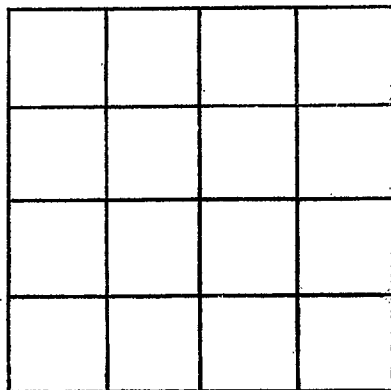

SECTION _____

Please indicate well location X.

ADDITIONAL INFORMATION

If more than one screen,
show locations of each on sketch.