

Washington  
S-99

MISSISSIPPI  
BOARD OF WATER COMMISSIONERS  
416 North State Street  
Jackson, Mississippi 39201

CODED

4/24/80

WATER WELL DRILLERS LOG

Well # I

April 24, 1980  
date well completed

Dreiling & Associates  
firm name

Washington  
county well located

LANDOWNER: W. C. Woodruff

description of formations encountered

from

to

~~WASHINGTON MISSISSIPPI 38745~~

GRACE, MISSISSIPPI 38745  
(mailing address)

Top Soil 0 5

Sand Clay 5 10

Clay Blue 10 15

Blue Clay 15 20

Blue Clay 20 25

Clay Blue 25 30

Sand & Clay 30 35

Sand 35 40

Sand & Gravel 40 45

Sand & Gravel 45 50

Sand & Gravel 50 55

Sand & Gravel 55 60

Sand & Gravel 60 65

Sand & Gravel 65 70

Sand & Gravel 70 75

Sand & Gravel 75 80

Sand & Gravel 80 85

Sand & Gravel 85 90

Sand & Gravel 90 95

Sand & Gravel 95 100

Sand & Gravel 100 105

Sand & Gravel 105 110

Fine Sand & Gravel 110 115

Sand and Gravel 115 120

Sand and Gravel 120 125

WELL LOCATION:

sec. 8 T 14 N R 27 E W  
2 miles N-E of Grace  
(distance) (direction) (nearest town)

WELL PURPOSE: Irrigation  
(home, irrigation, municipal, industrial)

WELL COMPLETION DATA:

(1) diameter (inches) 22'

(2) total depth (feet) 128'

(3) static water level (feet) 8 below top of ground.

(4) casing Steel (material), 125 (depth)

(size) if telescope see back.

(5) screen 40' (length), 88 (depth to top)

(size) (material)

(6) pump 60 (HP), 3800 (yield gpm)

Diesel (type power)

(7) electric log No (yes or no)

(organization running log)

(8) how well bottom plugged Clay

DRILLERS REMARKS:


DEPT. OF NATURAL RESOURCES  
BUREAU OF LAND & WATER RESOURCES

MAY 19 1980

RECEIVED

If well telescopes please sketch and show depths.

GROUND LEVEL

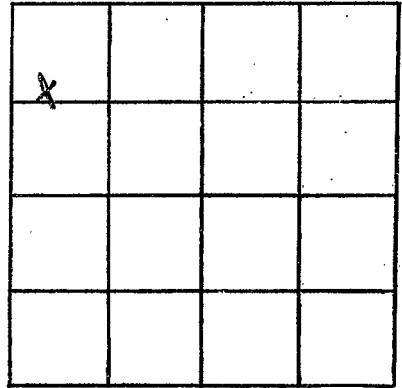

SECTION \_\_\_\_\_

Please indicate well location X.

ADDITIONAL INFORMATION

If more than one screen,  
show locations of each on sketch.