

Washington

S-100

6-2-80

6-2-80
date well completed
MS. 3864

MISSISSIPPI
BOARD OF WATER COMMISSIONERS
416 North State Street
Jackson, Mississippi 39201

WATER WELL DRILLERS LOG

CODED

19 Owens Plog. Inc. with Washington
firm name county well located

LANDOWNER: James K.
Kiker Rt 2 Box 140
Hollandale, ms, 38748
(mailing address)

description of formations encountered	from to	
top soil	0	30'
clay	30'	60'
Sand and gravel	60'	110'

WELL LOCATION:
sect ~~8-32~~ T 14 S R 8 E
3 miles E of Hollandale
(distance) (direction) (nearest town)

WELL PURPOSE:
(home, irrigation, municipal, industrial)

- WELL COMPLETION DATA:
- (1) diameter (inches) 4"
 - (2) total depth (feet) 110
 - (3) static water level (feet) 19 below top of ground.
 - (4) casing PVC 100' (material) (depth)
NO If telescope see back. (size)
 - (5) screen 10' 110' (length) (depth to top)
2" PVC (size) (material)
 - (6) pump 1 20 (HP) (yield gpm)
elec. (type power)
 - (7) electric log NO (yes or no)
 - (8) how well bottom plugged S/B

CODED

DEPT. OF NATURAL RESOURCES
BUREAU OF LAND & WATER RESOURCES


JUL 21 1980

RECEIVED

DRILLERS REMARKS:
Owens

If well telescopes please sketch and show depths.

GROUND LEVEL

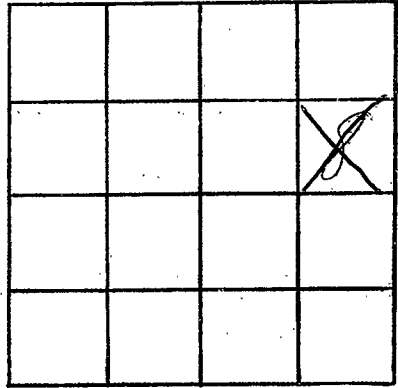

SECTION 8

Please indicate well location X.

ADDITIONAL INFORMATION

If more than one screen,
show locations of each on sketch.