

CODED

# 3

Washington  
S 102  
9/15/80

MISSISSIPPI  
BOARD OF WATER COMMISSIONERS  
416 North State Street  
Jackson, Mississippi 39201

WATER WELL DRILLERS LOG

Sept 15 1980 date well completed  
Dreiling & Associates firm name  
Washington county well located

LANDOWNER:  
W.C. Woodruff  
P.O. Box 126 , Grace MS 38745  
(mailing address)

WELL LOCATION:  
sec. 32 T 14 N R 7 E  
S W  
4 miles N of Grace  
(distance) (direction) (nearest town)

WELL PURPOSE: Irrigation  
(home, irrigation, municipal, industrial)

WELL COMPLETION DATA:  
(1) diameter (inches) 26"  
(2) total depth (feet) 130'  
(3) static water level (feet) 18 below top of ground.  
(4) casing steel 91'  
(material) (depth)  
10 (size) if telescope see back.  
(5) screen 41' 91'  
(length) (depth to top)  
16" steel  
(size) (material)  
(6) pump 65 3800  
(HP) (yield gpm)  
diesel  
(type power)  
(7) electric log no  
(yes or no)  
(organization running log)  
(8) how well bottom plugged  
m steel plug

description of formations encountered	from	to
Top Soil	0	5
Gray Clay/Wood	5	10
Blue Clay	10	15
Blue Clay	15	20
Blue gray clay fine sand	20	25
gray Clay/ Fine Sand	25	30
Fine Sand/Gray Clay/Gravel	30	35
Fine Sand /Lignight Coal	35	40
Gray Clay Fine Sand	40	45
Gray Clay/Fine Sand/LC	45	50
Kignight /Fine Sand	50	55
Med. Sand/Gray Clay	55	60
Gray Clayy/gravel/Med Sand	60	65
Gray Clay/Gravel/Med Sand	65	70
Course Sand/Gravel	75	80
Fine & Course Sand/Gravel	80	85
Gravel/Fine & Med.Sand	85	90
Gravel/Fine & Course Sand	90	95
Med. &Course Sand/ Gravel	95	100
Lignight Coal/Course Sand	100	105
Med Sand/Lignite Coal	105	110
Course& Med Sand/Gravel	110	115
Course Sand/ Gravel	115	120
Course Sand /Gravel	120	125
Course Sand/Gravel	125	130
Course Sand/Gravel	130	131
Course Sand /Gravel	130	132

DEPT. OF NATURAL RESOURCES  
BUREAU OF LAND & WATER RESOURCES


FEB 20 1981

RECEIVED

DRILLERS REMARKS:

If well telescopes please sketch and show depths.

GROUND LEVEL

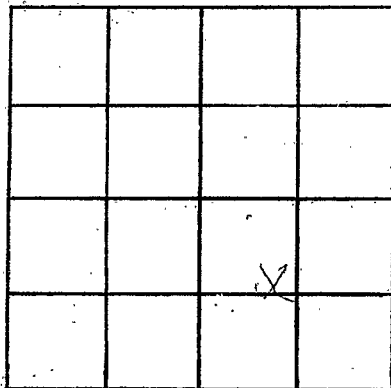

SECTION 32

Please indicate well location X.

ADDITIONAL INFORMATION

If more than one screen,  
show locations of each on sketch.