

WASHINGTON

S103

4-10-81

MISSISSIPPI  
 BOARD OF WATER COMMISSIONERS  
 416 North State Street  
 Jackson, Mississippi 39201

WATER WELL DRILLERS LOG

April 10 1981 Drilling & Assoc. WASHINGTON  
 date well completed firm name county well located

LANDOWNER: Humphrey McGEE

McGEE BRO.

Panther Burno Ms 38765  
 (mailing address)

WELL LOCATION:

sec 21 T14 N R 7 E  
 S W  
 4 miles E of NITTA YUM  
 (distance) (direction) (nearest town)

WELL PURPOSE:

(home, irrigation, municipal, industrial)

WELL COMPLETION DATA:

- (1) diameter (inches) 16"
- (2) total depth (feet) 132'
- (3) static water level (feet) 12' below top of ground.
- (4) casing STEEL 192'  
(material) (depth)  
 If telescope see back.  
(size)
- (5) screen 40' 92'  
(length) (depth to top)  
16" STEEL  
(size) (material)
- (6) pump 60 3800  
(HP) (yield gpm)  
DEISEL  
(type power)
- (7) electric log NO  
(yes or no)  
NO  
(organization running log)
- (8) how well bottom plugged STEEL  
plug


description of formations encountered

CODED

from to

TOP SOIL	0	5
CLAY	5	10
BROWN CLAY	10	75
"	15	20
"	20	25
FINE SAND	25	30
"	30	35
MED SAND + SMALL GRA	35	40
"	40	45
"	45	50
"	50	55
COURSE SAND + GRAU	55	60
"	60	65
MED SAND + GRAU	65	70
MED/FINE SAND/GRAU/COAL	70	75
COURSE SAND + GRAU	75	80
"	80	90
"	90	95
"	95	100
"	100	105
"	105	110
"	110	115
"	115	120
"	120	125
"	125	130
"	130	132
CLAY FINE SAND	130	132

CODED

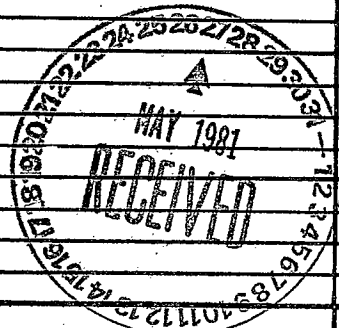

DRILLERS REMARKS:

