

MISSISSIPPI DEPARTMENT OF NATURAL RESOURCES

Bureau of Land and Water Resources

Southport Mall

P.O. Box 10631


Jackson, Mississippi 39209

WATER WELL DRILLERS LOG

Washington  
S 104  
3-24-81


March 24 19 81 date well completed Larry's Well & Pump firm name Washington county well located

LANDOWNER: <u>Pete Gresham</u> <u>4 C Land CO</u>	description of formations encountered	CODED	from	to
<u>Glen Allen</u> (mailing address)	<u>CLAY</u>	<u>0</u>	<u>40</u>	
WELL LOCATION: sec. <u>31</u> T. <u>14</u> N. R. <u>3</u> E <u>2</u> miles <u>E</u> of <u>Glen Allen</u> (distance) (direction) (nearest town)	<u>FINE SAND CLAY</u>	<u>10</u>	<u>75</u>	
WELL PURPOSE: (home, irrigation, municipal, industrial)	<u>CORSE SAND @ Ground</u>	<u>75</u>	<u>121</u>	
WELL COMPLETION DATA: (1) diameter (inches) <u>16"</u> (2) total depth (feet) <u>121'</u> (3) static water level (feet) <u>17</u> below above top of ground. (4) casing <u>Steel</u> , <u>81'</u> (material) (depth) (size) if telescope see back. (5) screen <u>40'</u> , <u>81'</u> (length) (depth to top) <u>16"</u> , <u>Steel</u> (size) (material) (6) pump _____ (HP) _____ (yield gpm) (type power) (7) electric log <u>NO</u> (yes or no) (organization running log) (8) how well bottom plugged <u>Steel Plate</u>	CODED			
DRILLERS REMARKS:				

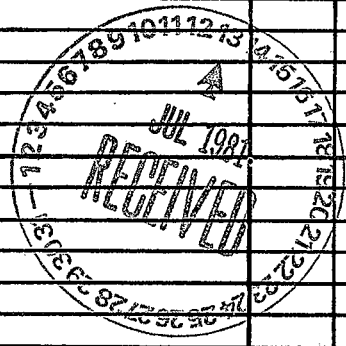

If well telescopes please sketch and show depths.

GROUND LEVEL

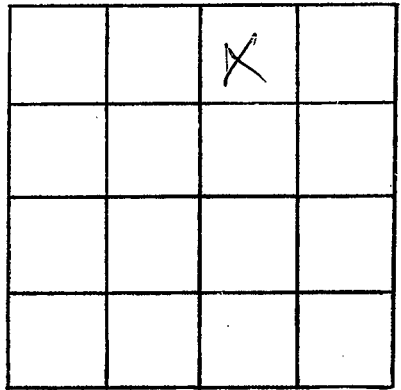

SECTION 31

Please indicate well location X.

ADDITIONAL INFORMATION

If more than one screen, show locations of each on sketch.