

MISSISSIPPI DEPARTMENT OF NATURAL RESOURCES

Bureau of Land and Water Resources

Southport Mall

P.O. Box 10631

Jackson, Mississippi 39209

WATER WELL DRILLERS LOG

CODED

WASHINGTON  
S 105  
10-30-81

~~30 Sept~~ Oct 1981 Lambert Drilling Wash  
date well completed firm name county well located

LANDOWNER:	description of formations encountered	from	to
Mr. Wade.			
Lake Washington Greenville (mailing address)	Mixed	0	5
WELL LOCATION:	Clay	5	15
sec. 4 T 14 N R 8 E W	Sand	15	60
1/8 miles S of Greenville (distance) (direction) (nearest town)	fine gravel	60	101
WELL PURPOSE: none (home, irrigation, municipal, industrial)	blue clay	101	160
WELL COMPLETION DATA:	Sand & clay	160	540
(1) diameter (inches) 4x2	rock	540	541
(2) total depth (feet) 825	Sand & clay	541	565
(3) static water level (feet) 22 below top of ground.	rock	565	582
(4) casing Steel, 805 (material) (depth)	Sand & gravel	582	570
4x2 If telescope see back. (size)	rock	570	571
(5) screen 20, 825-805 (length) (depth to top)	Blue sand	571	760
2" 55 (size) (material)	Sand	760	825
(6) pump 1, 20 (HP) (yield gpm)			
elect (type power)			
(7) electric log _____ (yes or no)			
(organization running log)			
(8) how well bottom plugged back press.			
DRILLERS REMARKS:			

CODED

DEPT. OF NATURAL RESOURCES  
BUREAU OF LAND & WATER RESOURCES

NOV 20 1981

RECEIVED


If well telescopes please sketch and show depths.

GROUND LEVEL

147 4''

805 2''

825 2 1/2''

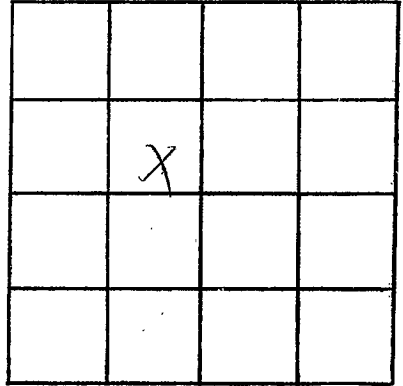

SECTION 28

Please indicate well location X.

ADDITIONAL INFORMATION

If more than one screen,  
show locations of each on sketch.