

MISSISSIPPI DEPARTMENT OF NATURAL RESOURCES

Bureau of Land and Water Resources

Southport Mall

P.O. Box 10631

Jackson, Mississippi 39209

WATER WELL DRILLERS LOG

CODED

WASA
S 106
10/6/81

Oct. 6, 1981 Bruce Berryman - WASHINGTON
 date well completed firm name county well located
 Greenwood. MS

LANDOWNER: Mrs. E.F. JONES
 P.O. Box 24,
 Glen Allan. MS 38744
 (mailing address)

WELL LOCATION:
 sec. 7 T. 14 N R. 8 E
 S W
 2 miles N of Glen Allan
 (distance) (direction) (nearest town)

WELL PURPOSE: Home
 (home, irrigation, municipal, industrial)

WELL COMPLETION DATA:

- (1) diameter (inches) 4" x 2"
- (2) total depth (feet) 924'
- (3) static water level (feet) 30' below top of ground.
- (4) casing 4" blk. - 126' (material) 2" galv. - 778' (depth)
- (size) if telescope see back.
- (5) screen 20' 904' (length) (depth to top)
- 2" .010 Stainless steel (size) (material)
- (6) pump 1 1/2 (HP) 30 (yield gpm)
- Electric (type power)
- (7) electric log No (yes or no)
- (organization running log)
- (8) how well bottom plugged B.P.V.

description of formations encountered	from	to
Clay	0	20
Sand	20	80
Sand & gravel	80	100
Clay	100	180
Sandy shale	180	220
Sand	220	320
Clay	320	330
Sand	330	340
Shale	340	390
Sand	390	410
Shale	410	440
Shale & Str. sand	440	500
Shale	500	520
Shale & rock	520	540
Shale	540	600
Shale & rock	600	620
Shale	620	650
Sand	650	660
Clay	660	690
Sand	690	710
Clay	710	730
Sand	730	740
Shale	740	780
Sand	780	800
Clay & rock	800	820
Clay	820	870
Sand	870	920
Clay	920	930

CODED

DEPT. OF NATURAL RESOURCES
 BUREAU OF LAND & WATER RESOURCES


APR 27 1982

RECEIVED

DRILLERS REMARKS:

If well telescopes please sketch and show depths.

GROUND LEVEL

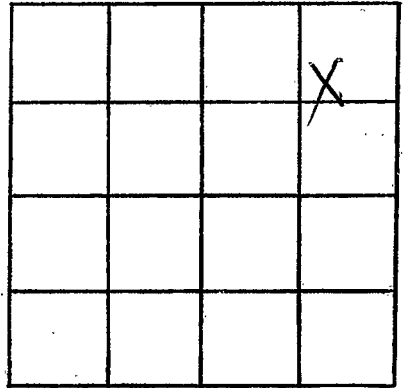

SECTION 7

Please indicate well location X.

ADDITIONAL INFORMATION

If more than one screen,
show locations of each on sketch.