

WASHINGTON
S 108

MISSISSIPPI DEPARTMENT OF NATURAL RESOURCES
Bureau of Land and Water Resources
Southport Mall
P.O. Box 10631
Jackson, Mississippi 39209
WATER WELL DRILLERS LOG

CODED

4-15-85 19 IRRIGATION EQUIPMENT WASHINGTON
date well completed firm name county well located

LANDOWNER: Boyd E. Fling
Rt. 1, BOX 285
Hollandale, MS
(mailing address)

| description of formations encountered | from | to |
|---------------------------------------|------------|------------|
| <u>FINE SAND</u> | <u>0</u> | <u>15</u> |
| <u>CLAY</u> | <u>15</u> | <u>40</u> |
| <u>FINE SAND</u> | <u>40</u> | <u>55</u> |
| <u>COURSE SAND</u> | <u>55</u> | <u>105</u> |
| <u>COURSE SAND / POA GRAVEL</u> | <u>105</u> | <u>110</u> |

WELL LOCATION:
sec. 4 T. 14 (N) R. 7 (E)
9 miles SW of Hollandale
(distance) (direction) (nearest town)

WELL PURPOSE: IRRIGATION
(home, irrigation, municipal, industrial)

- WELL COMPLETION DATA:
- (1) diameter (inches) 16"
 - (2) total depth (feet) 110
 - (3) static water level (feet) 12 below above top of ground.
 - (4) casing steel, 70'
(material), (depth)
 - (size) if telescope see back.
 - (5) screen 40', 70'
(length), (depth to top)
16", steel
(size), (material)
 - (6) pump 40, 2000
(HP), (yield gpm)
DIESEL POWER UNIT
(type power)
 - (7) electric log NO
(yes or no)
 - (organization running log)
 - (8) how well bottom plugged steel plate

CODED


RECEIVED
APR 23 1985

Department of Natural Resources
Bureau of Land & Water Resources

DRILLERS REMARKS:

If well telescopes please sketch and show depths.

GROUND LEVEL

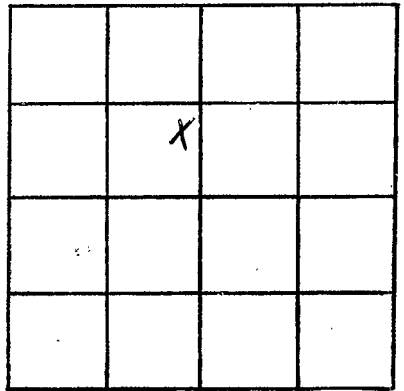

SECTION 4

Please indicate well location X.

ADDITIONAL INFORMATION

If more than one screen,
show locations of each on sketch.