

MISSISSIPPI DEPARTMENT OF NATURAL RESOURCES

Bureau of Land and Water Resources

Southport Mall

P.O. Box 10631

Jackson, Mississippi 39201 **CODED**

WATER WELL DRILLERS LOG

S 109  
WASHINGTON  
5-10-85

5-10-85  
date well completed

IRRIGATION EQUIPMENT  
firm name

WASHINGTON  
county well located

LANDOWNER: M.G. AND Lillie Johnson Foundation Inc. Box 508  
Wharton, TX 77488  
RICE (mailing address)

description of formations encountered	from	to
CLAY	0	45
FINE SAND	45	60
COURSE SAND / pea gravel	60	120

WELL LOCATION: SW 1/4 NE 1/4  
sec. 21 T. 14 N. R. 7 E  
10 miles NE of GRACE  
(distance) (direction) (nearest town)

**CODED**

WELL PURPOSE: IRRIGATION  
(home, irrigation, municipal, industrial)

WELL COMPLETION DATA:

- (1) diameter (inches) 16"
- (2) total depth (feet) 120
- (3) static water level (feet) 20 below top of ground.
- (4) casing steel / 80'  
(material) (depth)  
(size) if telescope see back.
- (5) screen 40' / 80'  
(length) (depth to top)  
16" / steel  
(size) (material)
- (6) pump 60 / 3200  
(HP) (yield gpm)  
Diesel  
(type power)
- (7) electric log (yes or no) \_\_\_\_\_  
(organization running log) \_\_\_\_\_
- (8) how well bottom plugged steel plate

**DECEASED**  
JUN 15 1985


Department of Natural Resources  
Bureau of Land and Water Resources

DRILLERS REMARKS:  
George MAHA/lite-Renter

If well telescopes please sketch and show depths.

IRRIGATION EQUIPMENT  
601/887-2555  
INDIANOLA, MS

GROUND LEVEL

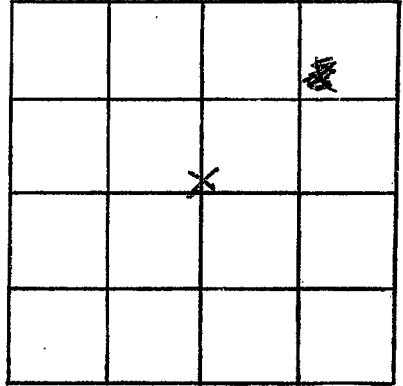

SECTION 21

Please indicate well location X.

ADDITIONAL INFORMATION

If more than one screen,  
show locations of each on sketch.