

MISSISSIPPI DEPARTMENT OF NATURAL RESOURCES <sup>P</sup>

Bureau of Land and Water Resources

Southport Mall

P.O. Box 10631

Jackson, Mississippi 39209

WATER WELL DRILLERS LOG

CODED

WASHINGTON  
S110  
4-15-85

April 15 1985 Larry's Well & pump Washington  
date well completed well name county well located.

LANDOWNER: Elting Farms

description of formations encountered

from

to

Hollandale, Ms.  
(mailing address)

clay  
Fine clay  
coarse sand & gravel  
0 26'  
26' 57'  
57 114'

WELL LOCATION:

sec. 18 T. 14 N R. E  
S W  
4 miles E of Glenn  
(distance) (direction) (nearest town)

CODED

WELL PURPOSE:


(home, irrigation, municipal, industrial)

WELL COMPLETION DATA:

- (1) diameter (inches) 16"
- (2) total depth (feet) 114'
- (3) static water level (feet) 20' below top of ground.
- (4) casing Steel, 74'  
(material) (depth)  
(size) If telescope see back.
- (5) screen 40', 74'  
(length) (depth to top)  
16', Steel  
(size) (material)
- (6) pump 40 2000  
(HP) (yield gpm)  
DSL  
(type power)
- (7) electric log No  
(yes or no)

(organization running log)

(8) how well bottom plugged Steel Plate

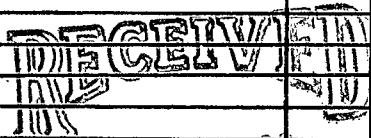

Department of Natural Resources  
Bureau of Land & Water Resources

DRILLERS REMARKS:

If well telescopes please sketch and show depths.

GROUND LEVEL

X			

SECTION 18

Please indicate well location X.

ADDITIONAL INFORMATION

If more than one screen, show locations of each on sketch.