

MISSISSIPPI DEPARTMENT OF NATURAL RESOURCES P

Bureau of Land and Water Resources

Southport Mall

P.O. Box 10631

Jackson, Mississippi 39209

WATER WELL DRILLERS LOG

CODED

WASHINGTON
S III
4-15-85

April 15 1985 date well completed
Lannis Well & Pump firm name
Washington county well located

LANDOWNER: Effing Farms

description of formations encountered

from to

clay	0	25
Fine sand	25	48
coarse sand & gravel	48	104

Hollandale, Miss.
(mailing address)

WELL LOCATION:

sec. 18 T. 14 N R. E
S W
4 miles E of Okemallen
(distance) (direction) (nearest town)

CODED

WELL PURPOSE:

(home, irrigation, municipal, industrial)

WELL COMPLETION DATA:

- (1) diameter (inches) 16"
- (2) total depth (feet) 104'
- (3) static water level (feet) 21' below top of ground.
- (4) casing Steel, 64' (material) (depth)
- (size) If telescope see back.
- (5) screen 40' 64' (length) (depth to top)
- (size) Steel (material)
- (6) pump 40 (HP) 2000 (yield gpm)
- DS1 (type power)
- (7) electric log NO (yes or no)

RECEIVED

JUN 17 1986

Department of Natural Resources
Bureau of Land & Water Resources


(organization running log)

(8) how well bottom plugged Steel Plate

DRILLERS REMARKS:

If well telescopes please
sketch and show depths.

GROUND LEVEL

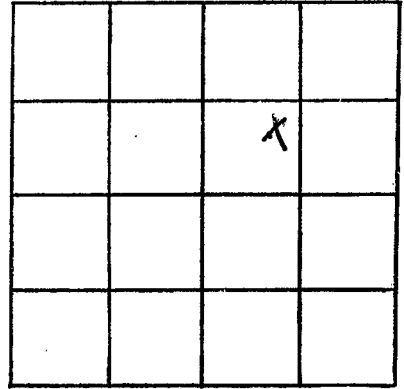

SECTION 18

Please indicate well location X.

ADDITIONAL INFORMATION

Lined area for additional information.

If more than one screen,
show locations of each on sketch.