

MISSISSIPPI DEPARTMENT OF NATURAL RESOURCES

Bureau of Land and Water Resources

Southport Mall

P.O. Box 10631

Jackson, Mississippi 39209

WATER WELL DRILLERS LOG

INDEXED

WASHINGTON
5113

March 27 1986 date well completed
Larry's well, pump firm name
Washington county well located

LANDOWNER: Metropolitan Insurance
Greenville, Ms.
(mailing address)

description of formations encountered	depth	
	from	to
Clay	0	30
Fine Sand	30	60
coarse Sand & gravel	60	116

WELL LOCATION:
sec. 30 T. 14 N R. 7 E
S 7 W
4 miles East of Glen Allen
(distance) (direction) (nearest town)

CODED

WELL PURPOSE:
(home irrigation) municipal, industrial

WELL COMPLETION DATA:

(1) diameter (inches) 12"

(2) total depth (feet) 116'

(3) static water level (feet) 15' below top of ground.


(4) casing Steel, 76' (material) (depth)
(size) if telescope see back.

(5) screen 40' 76' (length) (depth to top)
12" Steel (size) (material)

(6) pump 40 2000 (HP) (yield gpm)
D (type power)

(7) electric log No (yes or no)
(organization running log)

(8) how well bottom plugged Steel Plate

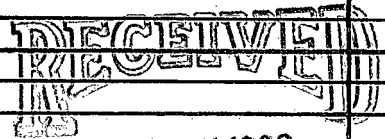

SEP 25 1986

Department of Natural Resources
Bureau of Land & Water Resources

DRILLERS REMARKS:

If well telescopes please sketch and show depths.

GROUND LEVEL

X			

SECTION 30

Please indicate well location X.

ADDITIONAL INFORMATION

If more than one screen,
show locations of each on sketch.