

WASHINGTON  
S 115

MISSISSIPPI DEPARTMENT OF NATURAL RESOURCES  
Bureau of Land and Water Resources  
Southport Mall  
P.O. Box 10631  
Jackson, Mississippi 39209  
WATER WELL DRILLERS LOG

CODED

October 21 1986 Bruce Berryman Washington  
date well completed firm name county well located  
Greenwood

LANDOWNER: Assembly of God Church  
P.O. Box 127,  
Glen Allen MS 38746  
(mailing address)

description of formations encountered	from	to
Clay	0	20
Sand	20	100
Clay	100	160
Sandy Clay	160	220
Sand	220	280
Sandy clay	280	360
Sand	360	400
Clay & str. sand	400	520
Clay	520	540
Clay & str. sand	540	620
Brown sand	620	640
Shale	640	865
Sand	865	885
Shale	885	944
Fine white sand	944	964
Sand fine	964	1003
Sand	1003	1042
Clay	1042	1052

WELL LOCATION:  
sec. 7 T. 14 N R. 8 E  
S W  
3 miles east of Glen Allen  
(distance) (direction) (nearest town)

WELL PURPOSE: Church  
(home, irrigation, municipal, industrial)

WELL COMPLETION DATA:  
(1) diameter (inches) 4" x 2"  
(2) total depth (feet) 1040'  
(3) static water level (feet) 28' below top of ground. blk - 126'  
(4) casing 2" gal. - 903'  
(material) (depth)

\_\_\_\_\_ If telescope see back.  
(size)

(5) screen 20' / 1020'  
(length) (depth to top)

2" .010 ga. Stainless steel  
(size) (material)

(6) pump 1 h.p. 20  
(HP) (yield gpm)

Electric  
(type power)

(7) electric log NO  
(yes or no)

\_\_\_\_\_ (organization running log)

(8) how well bottom plugged B.P.V.

DRILLERS REMARKS:


RECEIVED

MAR 18 1987

Department of Natural Resources  
Bureau of Land & Water Resources

If well telescopes please sketch and show depths.

GROUND LEVEL

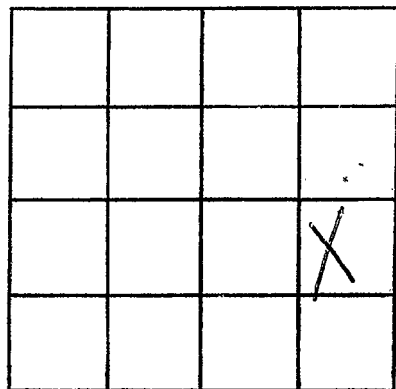

SECTION Z

Please indicate well location X.

ADDITIONAL INFORMATION

If more than one screen,  
show locations of each on sketch.