

MISSISSIPPI DEPARTMENT OF NATURAL RESOURCES

Bureau of Land and Water Resources

Southport Mall

P.O. Box 10631

Jackson, Mississippi 39209 CODED

WATER WELL DRILLERS LOG

TEP  
WASHINGTON  
07753-DEP-09-14-87  
S 119

14-87  
D:53-87

7-15 1987  
date well completed

Dyer Well, Inc Washington  
firm name county well located

LANDOWNER: Robroy D. Fisher

Rt. 1, Box 220

Blen Allen, Miss  
(mailing address)

WELL LOCATION:

sec. 4 T. 14 N R. 8 E  
S W

(distance) miles (direction) of (nearest town)

WELL PURPOSE: Irrigation  
(home, irrigation, municipal, industrial)

WELL COMPLETION DATA:

(1) diameter (inches) 12"  
(2) total depth (feet) 105  
(3) static water level (feet) below above top of ground.

(4) casing Steel (material), (depth),  
12" (size) if telescope see back.

(5) screen 40 (length), (depth to top)  
12" (size), (material)

(6) pump (HP) (yield gpm)  
(type power)

(7) electric log No (yes or no)  
(organization running log)

(8) how well bottom plugged Plate

description of formations encountered

from to

Clay	0	28
fine sand	28	85
Sand + gravel	85	105

RECEIVED

JUL 20 1987


Department of Natural Resources  
Bureau of Land & Water Resources

DRILLERS REMARKS:

TEP  
07753-DEP-09-14-87

If well telescopes please sketch and show depths.

GROUND LEVEL

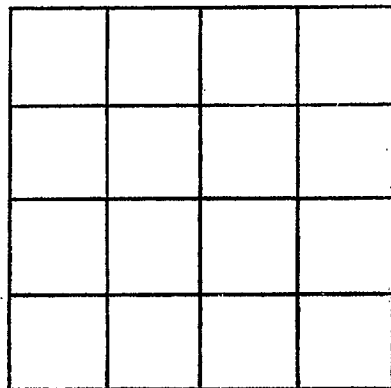

SECTION \_\_\_\_\_

Please indicate well location X.

ADDITIONAL INFORMATION

If more than one screen,  
show locations of each on sketch.