

W.C.

MISSISSIPPI DEPARTMENT OF ENVIRONMENTAL QUALITY

Office of Land and Water Resources

P. O. Box 10631

Jackson, MS 39289-0631

WATER WELL DRILLERS LOG

COUNTY WELL LOCATED Washington	
WELL NUMBER S-139	CODED
DATE WELL COMPLETED 5-28-02	

PERMIT NUMBER
NAME OF DRILLING FIRM Chicot Irrigation, Inc.

NAME & MAILING ADDRESS OF LANDOWNER W.C. WOODRUFF PO Box 126 GRACE, MS. 38745			
Latitude: 33 01 24 Longitude: 090 58 46			
WELL LOCATION	SEC	TOWNSHIP	RANGE
NW/NW	36	14	S 8 E
DISTANCE	DIRECTION	NEAREST TOWN	
4	Miles EAST	of Glenn Allen	
OTHER LANDMARK Yazoo Wildlife Refuge			
WELL PURPOSE: Home Irrigation Municipal, Industrial, Fish Pond, etc.			

PUMP DATA		
PUMP TYPE (Circle One): Submersible, Turbine, Jet, Flowing Well, Other (Describe)		
POWER TYPE (Circle One): Electric, Tractor, Diesel, Gasoline, Butane, Other (Describe) H/P 60		
DESCRIPTION OF FORMATIONS ENCOUNTERED	FROM	TO
Top Soil	0	10
Fine Sand	10	70
Coarse Sand	70	120
Fine Sand	120	123
RECEIVED		
JUN 07 2002		
Dept. of Environmental Quality Office of Land & Water Resources		
Top of Lap Pipe or Reduction in Casing		
FEET	IF TELESKOPED OR MORE THAN ONE SCREEN: USE BACK PAGE	

WELL DATA

Well Depth 120	Casing Diameter (In.) 16	Casing Length (Ft.) 70
Type of Casing PUC	Hole Depth 123	Depth to Static Water Level
TYPE OF COMPLETION: (Circle One or More): Gravel Packed, Underreamed, Telescoped, Natural Development, Open Hole, Other (Describe)		
WELL GROUDED TO A DEPTH OF FEET Type Grout (circle one): Cement, Bentonite, or Mix		

SCREEN DATA

Diameter - Inches 16	Length - Feet 50	Slot Size - Inches 051
Screen Type PUC	Depth to Bottom - Feet 120	


I certify that the well was drilled, constructed and completed in accordance with all applicable Requirements of the Mississippi Department of Environmental Quality and/or the Mississippi Department of Health regulations and state laws.

Signature of Licensed Driller and License No. 0339

Date 6/4/02

Additional Information Required On Back

If well telescopes please sketch and show depths.

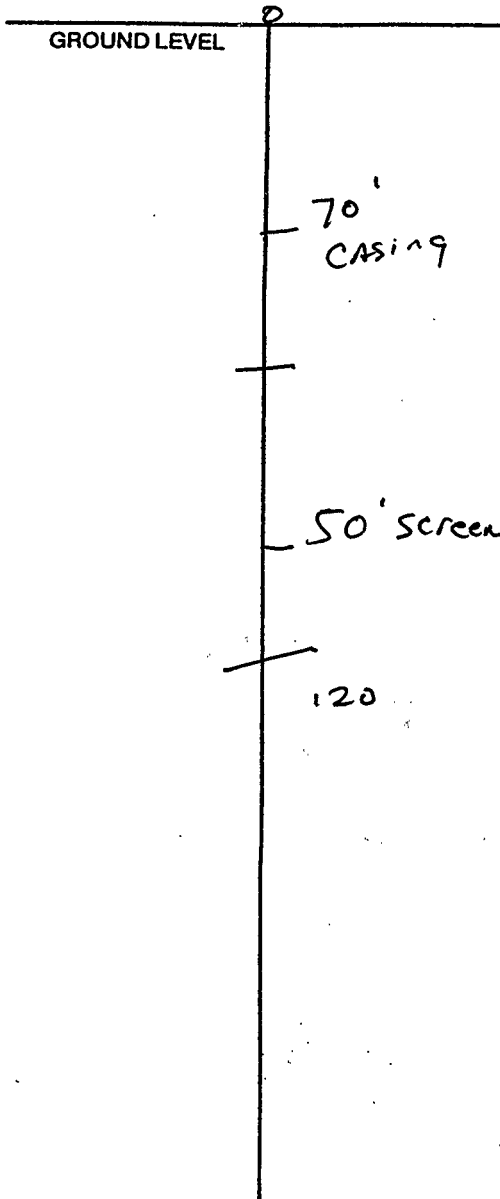

			X

SECTION 36

Please indicate well location X.

Pump Capacity (GPM)	No. of Stages	Setting Depth	FT.
PUMP TEST			
Well yielded _____ GPM with a drawdown of _____ ft. after _____ hours of pumping			

LOG DATA

TYPE OF LOG RUN (Circle One):		No-Log RUN.
Electric, Gamma Ray, Density, Sonic, Neutron, Other (Describe)		_____
Name of Organization Running Log		

GEOLOGIC DATA (Office Use Only)

Surface Elev.	Geologic Unit	Unit Thickness	Depth to Top
Subs. SWL	Date	Analysis	Aquifer Test

Driller's Remarks

If more than one screen, show location of each on sketch.