
	MARIN u	usike-		
	State W	ell Report		
COUNTY: WASHINGTON		art 1	For Office Use Only:	
	Mississippi Departmen	t of Environmental Quality	Aquifer: 5 168	
Permit #: <u>GW44471</u>		nd Water Resources Sox 10631	Well #:	
Driller: J. HEY/CONE 0.773		IS 39289-0631	L. S. Elevation:	
Date drilling completed: $6 - 18 - 10$	(601)	961-5210	E-log #:	
	(601)354	4-6938 (fax)	E-iog #:	
State Law requires that this rep 30 days of completion of drilling	ort be prepared by the of the well.			
Well Owner Inform	ation	Wei Wei	l Location	
Owner Name Reality Farm	15 Partnerstig	Latitude: 33 • 01 • 3	" Longitude: <u>1.01.44</u>	
Mailing Address: <u>70 357 2</u>		Method of Lat/Long (circle o	ne): Conventional Survey,	
			d GPS, Survey-grade GPS	
Storeville, City St	ng 38776 ate Zin Code	IR IR Direction	3 Twn 14N Rng BIH	
Telephone No. ()		Distance Direction O. Miles	Nearest Town	
- <u> </u>	Well	Data		
Purpose of Well (circle one) Home In			- 1	
Date well drilling started: 6-18	- 10 Date	well drilling completed:	-18-10	
If flowing, method of flow regulation: V	alve Other (describe)		
Static Water Level:feet :	above or below (circle one)	land surface Date measured	;	
Method of Measurement (circle one)	steel tape electric tap	e air line other:		
Hole depth: <u>113</u> Well d				
Type of grout (circle one): Cement				
Casing length: <u>70</u> feet Ca			Prc	
Screen length: <u>40</u> feet Sc	reen diameter: 16	inches Type of screen:	PVC	
Screen slot size:	s Setting depth: From	<u>70</u> feet to	110 feet	
Type of completion (circle all applicable	:): Gravel packed Und	erreamed Telescoped Op	en hole Natural Development	
	Other (describe):			
Top of lap pipe or reduction in casing: _	feet. If	telescoped or more than one s	creen, describe on back of page	
Logs run (circle all applicable) No log		-		
Name of organization running log(s)				
Name of organization running log(s): I certify that the well was drilled, cons	structed, and completed in	accordance with all applicab	le requirements of the Mississippi	
Department of Environmental Quality	y and/or the Mississippi D	epartment of Health regulation	ns and state laws.	
JOHN NEWCOME	0773	201	New	
Print Name of Water Well Contractor a	nd License No.	Signature	of Water Well Contractor	
Rec per	trill (0		印化
			to base with a plane	VE
jer	mit		AUG U 2	20.1
			SVO	141
				181

If well telescopes please sketch below and show depths.



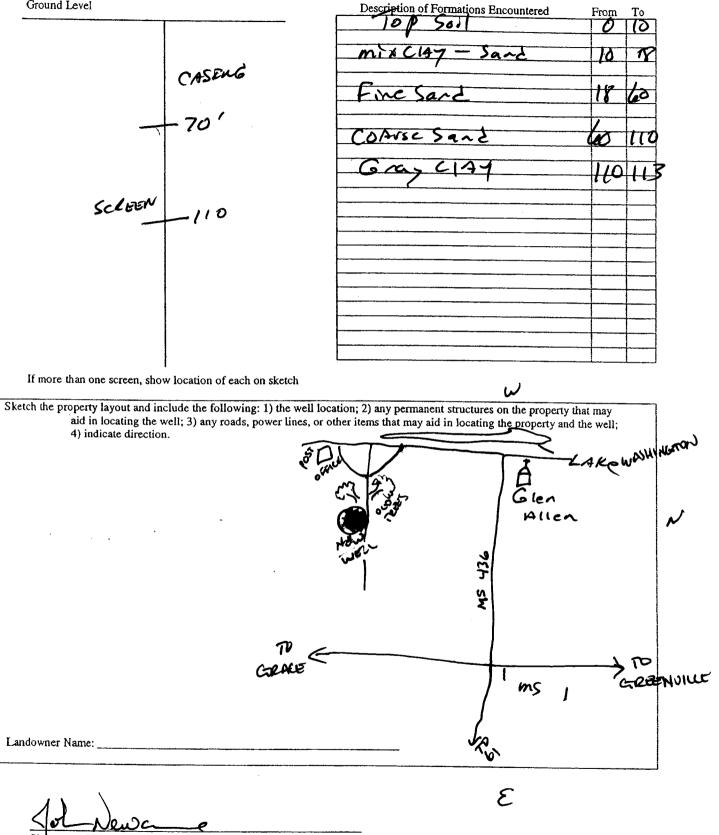

ature of Water Well Contractor

5

	STALL W	ELL REPORT	
		Part 2	For Office II. C. 1
County: Mashington	Pump Installer's Completion Report Mississippi Department of Environmental Quality		For Office Use Only:
County: Mashington	Mississippi Departme Office of Land	and Water Resources	Aquifer: 5168
Driller J. Neurome 0->>3	P.O .	Box 10631	
		MS 39289-0631 1)961-5210	Well #:
Date completed: 6-18-10		54-6938 (fax)	Elevation:
This report should be prepared by the installation of pump.	e pump installer in det	ail and filed with the Departme	at within 30 days of the
Well Owner Informati	on	We	Il Location
Owner Name: Reality Facms	Partnership		Longinude: 9991 01 44
Mailing Address: Po Box 273		Method of Lat/Long (circle one): Conventional Survey,	
			1-heid GPS, Survey-grade GPS
Stoneville m City State	5 38776 Zip Code	1 1/2 NW 1/4 Sec 9	Twn/UN Rng &W
	• • •	Distance Direction	Nearest Town
Telephone No. ()		O.I Miles E	Glen Allren
	······		
Ршир Туре		Po	wer Type
Circle one			fircle one
Air Lift Jet	Submersible	Diesel Engine Gasoli	ne Engine Natural Gas
Bucket Piston	Turbine	Electric Motor Hand	Tractor PTO
Centrifugal Rotary	Flowing Well	Windmill Other	(specify):
Other (specify):		Horse Power Rating of Motor	$\hat{\mathbf{C}}$
Date Pump Installed: 6/18/10			
		Setting Depth: 70	feet
Rated Pump Capacity: 3000	Gallons Per Minute	Number of Stages:	
Pumn Test Data			
Pump Test Data			easuring Water Level
Date Well Tested:		· · · · ·	asuring Water Level
Date Well Tested:		Air Line Electric Mea	easuring Water Level Incle one asuring Line Steel Tape
Date Well Tested:Feet] Static Water Level (A):Feet]	Below Land Surface	· · · · ·	easuring Water Level Incle one asuring Line Steel Tape
Date Well Tested:Feet 1 Static Water Level (A):Feet 1 Pumping Water Level (B):Feet I	Below Land Surface Below Land Surface	Air Line Electric Mea Other (specify):	easuring Water Level Encle one asuring Line Steel Tape
Date Well Tested:Feet 1 Static Water Level (A):Feet 1 Pumping Water Level (B):Feet I	Below Land Surface Below Land Surface	Air Line Electric Mea Other (specify):	easuring Water Level Incle one asuring Line Steel Tape
Date Well Tested:Feet] Static Water Level (A):Feet] Pumping Water Level (B):Feet] Drawdown [(B) – (A)]:Feet]	Below Land Surface Below Land Surface Below Land Surface	Air Line Electric Mea Other (specify):	Pasuring Water Level Encle one assuring Line Steel Tape
Date Well Tested:Feet] Static Water Level (A):Feet] Pumping Water Level (B):Feet] Drawdown [(B) – (A)]:Feet] Test Pumping Rate:	Below Land Surface Below Land Surface Below Land Surface Gallons Per Minute	Air Line Electric Mea Other (specify): For flowing well, measured sh Well yielded	Easuring Water Level Ericle one assuring Line Steel Tape but in head:feet GPM with a drawdown of
Date Well Tested:Feet] Static Water Level (A):Feet] Pumping Water Level (B):Feet] Drawdown [(B) – (A)]:Feet] Test Pumping Rate:	Below Land Surface Below Land Surface Below Land Surface Gallons Per Minute	Air Line Electric Mea Other (specify): For flowing well, measured sh Well yielded	Pasuring Water Level Encle one assuring Line Steel Tape
Date Well Tested:Feet I Static Water Level (A):Feet I Pumping Water Level (B):Feet I Drawdown [(B) – (A)]:Feet I Test Pumping Rate: Duration of Pump Test (minimum 4 hours):	Below Land Surface Below Land Surface Below Land Surface Gallons Per Minute bours	Air Line Electric Mea Other (specify): For flowing well, measured si Well yielded feet after	Easuring Water Level Ericle one assuring Line Steel Tape but in head:feet GPM with a drawdown of
Date Well Tested:Feet I Static Water Level (A):Feet I Pumping Water Level (B):Feet I Drawdown [(B) – (A)]:Feet I Test Pumping Rate: Duration of Pump Test (minimum 4 hours): I HEREBY CERTIFY that the above statem	Below Land Surface Below Land Surface Below Land Surface Gallons Per Minute bours	Air Line Electric Mea Other (specify): For flowing well, measured si Well yielded feet after	Easuring Water Level Ericle one assuring Line Steel Tape but in head:feet GPM with a drawdown of
Date Well Tested:Feet I Static Water Level (A):Feet I Pumping Water Level (B):Feet I Drawdown [(B) – (A)]:Feet I Test Pumping Rate: Duration of Pump Test (minimum 4 hours): I HEREBY CERTIFY that the above statem ROWR	Below Land Surface Below Land Surface Gallons Per Minutebours ents are true to the best	Air Line Electric Mea Other (specify): For flowing well, measured si Well yielded feet after	Easuring Water Level Ericle one assuring Line Steel Tape but in head:feet GPM with a drawdown of
Date Well Tested:Feet I Static Water Level (A):Feet I Pumping Water Level (B):Feet I Drawdown [(B) – (A)]:Feet I Test Pumping Rate: Duration of Pump Test (minimum 4 hours): I HEREBY CERTIFY that the above statem	Below Land Surface Below Land Surface Gallons Per Minutebours ents are true to the best	Air Line Electric Mea Other (specify): For flowing well, measured si Well yielded feet after	Pasuring Water Level Sincle one assuring Line Steel Tape but in head:feet GPM with a drawdown of hours of pumping
Date Well Tested:Feet I Static Water Level (A):Feet I Pumping Water Level (B):Feet I Drawdown [(B) – (A)]:Feet I Test Pumping Rate: Duration of Pump Test (minimum 4 hours): I HEREBY CERTIFY that the above statem ROWR	Below Land Surface Below Land Surface Gallons Per Minutebours ents are true to the best	Air Line Electric Mea Other (specify): For flowing well, measured si Well yielded feet after of my knowledge.	Pasuring Water Level Sincle one assuring Line Steel Tape but in head:feet GPM with a drawdown of hours of pumping
Date Well Tested:Feet I Static Water Level (A):Feet I Pumping Water Level (B):Feet I Drawdown [(B) – (A)]:Feet I Test Pumping Rate: Duration of Pump Test (minimum 4 hours): I HEREBY CERTIFY that the above statem ROWR	Below Land Surface Below Land Surface Gallons Per Minutebours ents are true to the best	Air Line Electric Mea Other (specify): For flowing well, measured si Well yielded feet after of my knowledge.	Assuring Water Level Sincle one assuring Line Steel Tape mut in head:feet feet fours of pumping nstaller
Date Well Tested:Feet I Static Water Level (A):Feet I Pumping Water Level (B):Feet I Drawdown [(B) – (A)]:Feet I Test Pumping Rate: Duration of Pump Test (minimum 4 hours): I HEREBY CERTIFY that the above statem ROWR	Below Land Surface Below Land Surface Gallons Per Minutebours ents are true to the best	Air Line Electric Mea Other (specify): For flowing well, measured si Well yielded feet after of my knowledge.	Pasuring Water Level Sincle one assuring Line Steel Tape but in head:feet GPM with a drawdown of hours of pumping

.