

MISSISSIPPI DEPARTMENT OF NATURAL RESOURCES

Bureau of Land and Water Resources

Southport Mall

P.O. Box 10631

Jackson, Mississippi 39209

WATER WELL DRILLERS LOG

Washington
51001

29 May 1984 Lambert Drilling Wash
date well completed firm name county well located

LANDOWNER:	description of formations encountered	from	to
<u>Cooper,</u> <u>Glenn Allen, Miss.</u> (mailing address)	<u>mixed</u>	<u>0</u>	<u>30</u>
WELL LOCATION: sec. <u>34</u> T. <u>14</u> N. R. <u>8</u> E S W <u>2</u> miles <u>E</u> of <u>Glenn Allen</u> (distance) (direction) (nearest town)	<u>Sand</u>	<u>30</u>	<u>60</u>
WELL PURPOSE: <u>Irrigational</u> (home, irrigation, municipal, industrial)	<u>Red gravel</u>	<u>60</u>	<u>110</u>
WELL COMPLETION DATA: (1) diameter (inches) <u>6</u> (2) total depth (feet) <u>110</u> (3) static water level (feet) <u>12</u> below above top of ground. (4) casing <u>PVC</u> , <u>90</u> (material) (depth) <u>206</u> if telescope see back. (size) (5) screen <u>20</u> , <u>110-90</u> (length) (depth to top) <u>6</u> , <u>PVC</u> (size) (material) (6) pump _____ (HP) _____ (yield gpm) (type power) _____ (7) electric log <u>no</u> (yes or no) (organization running log) _____ (8) how well bottom plugged <u>Cap</u>			
DRILLERS REMARKS:			

DEPT. OF NATURAL RESOURCES
BUREAU OF LAND & WATER RESOURCES

AUG 15 1984


RECEIVED

If well telescopes please sketch and show depths.

GROUND LEVEL

6'

110 St

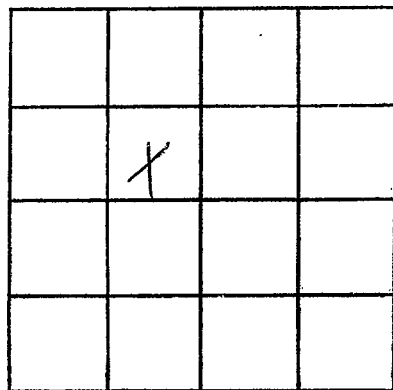

SECTION 39

Please indicate well location X.

ADDITIONAL INFORMATION

If more than one screen,
show locations of each on sketch.