

WASHINGTON
 S 2000
 4-11-75

MISSISSIPPI
 BOARD OF WATER COMMISSIONERS
 416 North State Street
 Jackson, Mississippi 39201

WATER WELL DRILLERS LOG


4-11 date well completed
 1975 DeForest Drilling Co firm name
 Washington county well located

LANDOWNER:	description of formations encountered	from	to
Arch (mailing address)	Clay Sand	0 11	11 60
WELL LOCATION: sec. 15 T 14 N R 8 E 7 miles n/w of Glendale (distance) (direction) (nearest town)	50 ft from end of Lake Washington 1 north end of Lake		
WELL PURPOSE: Farm (home, irrigation, municipal, industrial)			
WELL COMPLETION DATA:			
(1) diameter (inches) 4"			
(2) total depth (feet) 60			
(3) static water level (feet) 16 below top of ground.			
(4) casing PVC 60 (material) (depth)			
4" if telescope see back. (size)			
(5) screen 20 40 (length) (depth to top)			
4" PVC (size) (material)			
(6) pump 1 1/2 35 (HP) (yield gpm)			
AC (type power)			
(7) electric log no (yes or no)			
(organization running log)			
(8) how well bottom plugged leak wash valve			
DRILLERS REMARKS:			

MAR 29 1976
 MISSISSIPPI BOARD OF WATER COMMISSIONERS

If well telescopes please sketch and show depths.

GROUND LEVEL

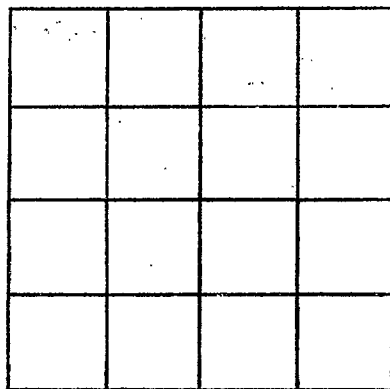

SECTION _____

Please indicate well location X.

ADDITIONAL INFORMATION

If more than one screen, show locations of each on sketch.